
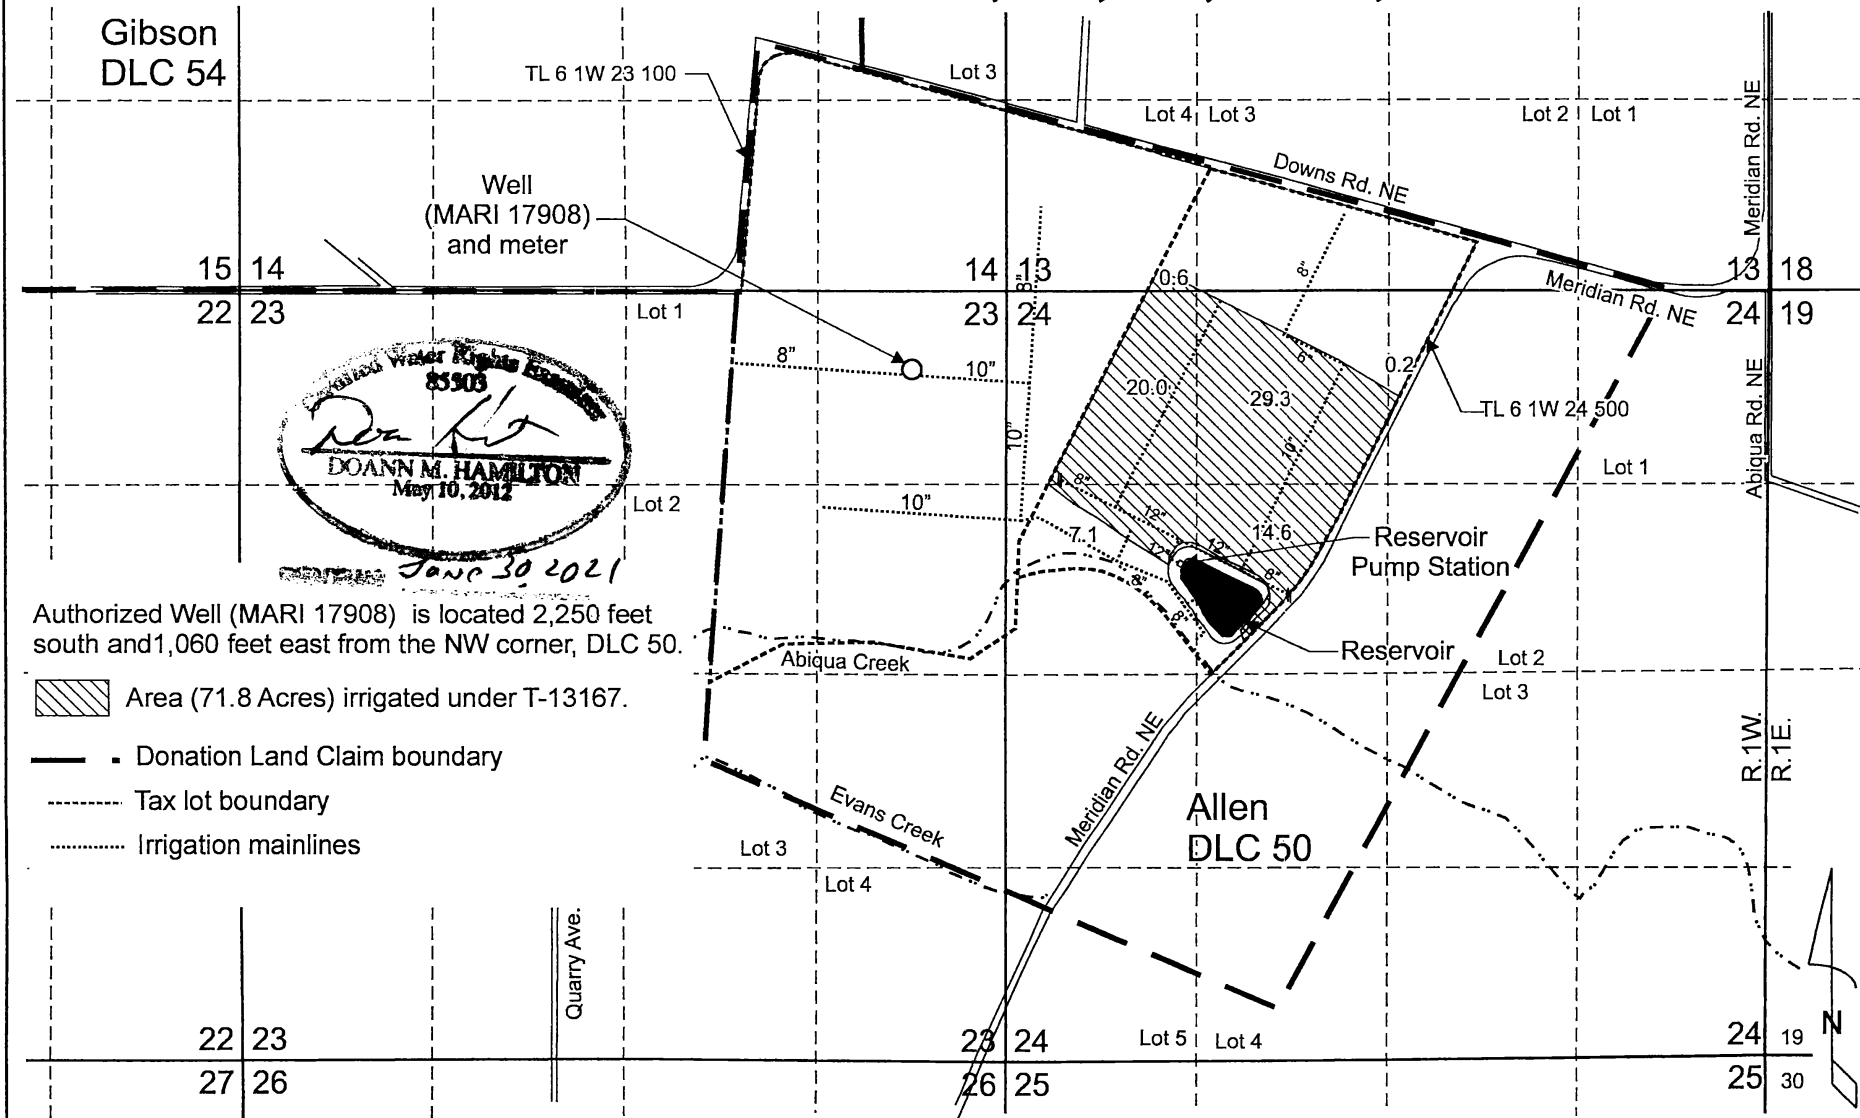



T.6S. R.1W. Sec. 13, 14, 23, & 24, W.M.

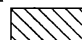

Authorized Well (MARI 17908) is located 2,250 feet south and 1,060 feet east from the NW corner, DLC 50.


 Area (71.8 Acres) irrigated under T-13167.

 Donation Land Claim boundary

 Tax lot boundary

 Irrigation mainlines

Scale: 1" = 1,320'

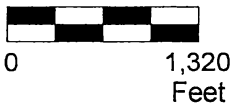

This map was prepared for the purpose of identifying the location of a water right only and is not intended to provide legal dimensions or location of property ownership lines.

Pacific Hydro-Geology Inc.

11/2019

Claim of Beneficial Use Map
T-13167

Paul Kraemer
T.6S. R.1W. Sec. 13, 14, 23, & 24, W.M.