


T.36 S., R.4 W.
 Scale 1 inch = 200 feet
 RIVERDALE TRACTS

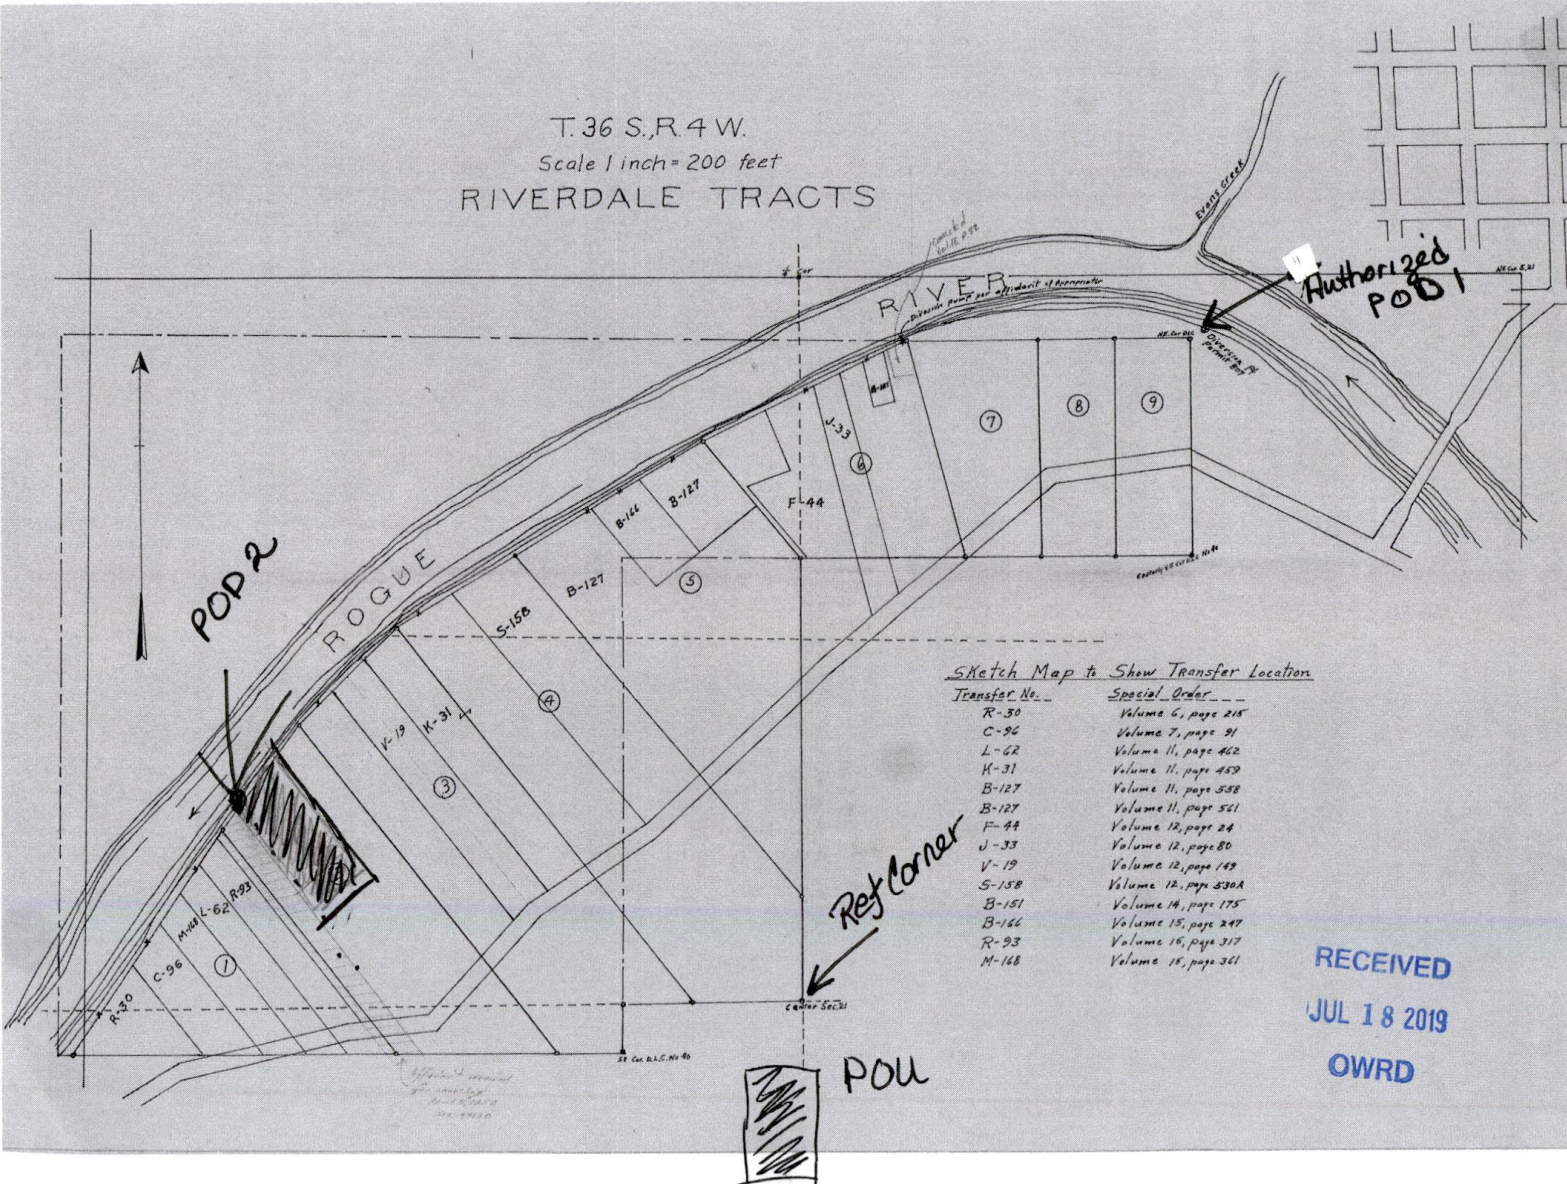

Sketch Map to Show Transfer Location

Transfer No.	Special Order
R-30	Volume 6, page 215
C-96	Volume 7, page 51
L-62	Volume 11, page 462
K-31	Volume 11, page 459
B-127	Volume 11, page 538
B-127	Volume 11, page 561
F-44	Volume 12, page 24
J-33	Volume 12, page 80
V-19	Volume 12, page 142
S-158	Volume 12, page 830A
B-151	Volume 14, page 175
B-166	Volume 15, page 249
R-93	Volume 15, page 317
M-168	Volume 15, page 351

RECEIVED
 JUL 18 2019
 OWRD