


T.36 S., R.4 W.
 Scale 1 inch = 200 feet
 RIVERDALE TRACTS

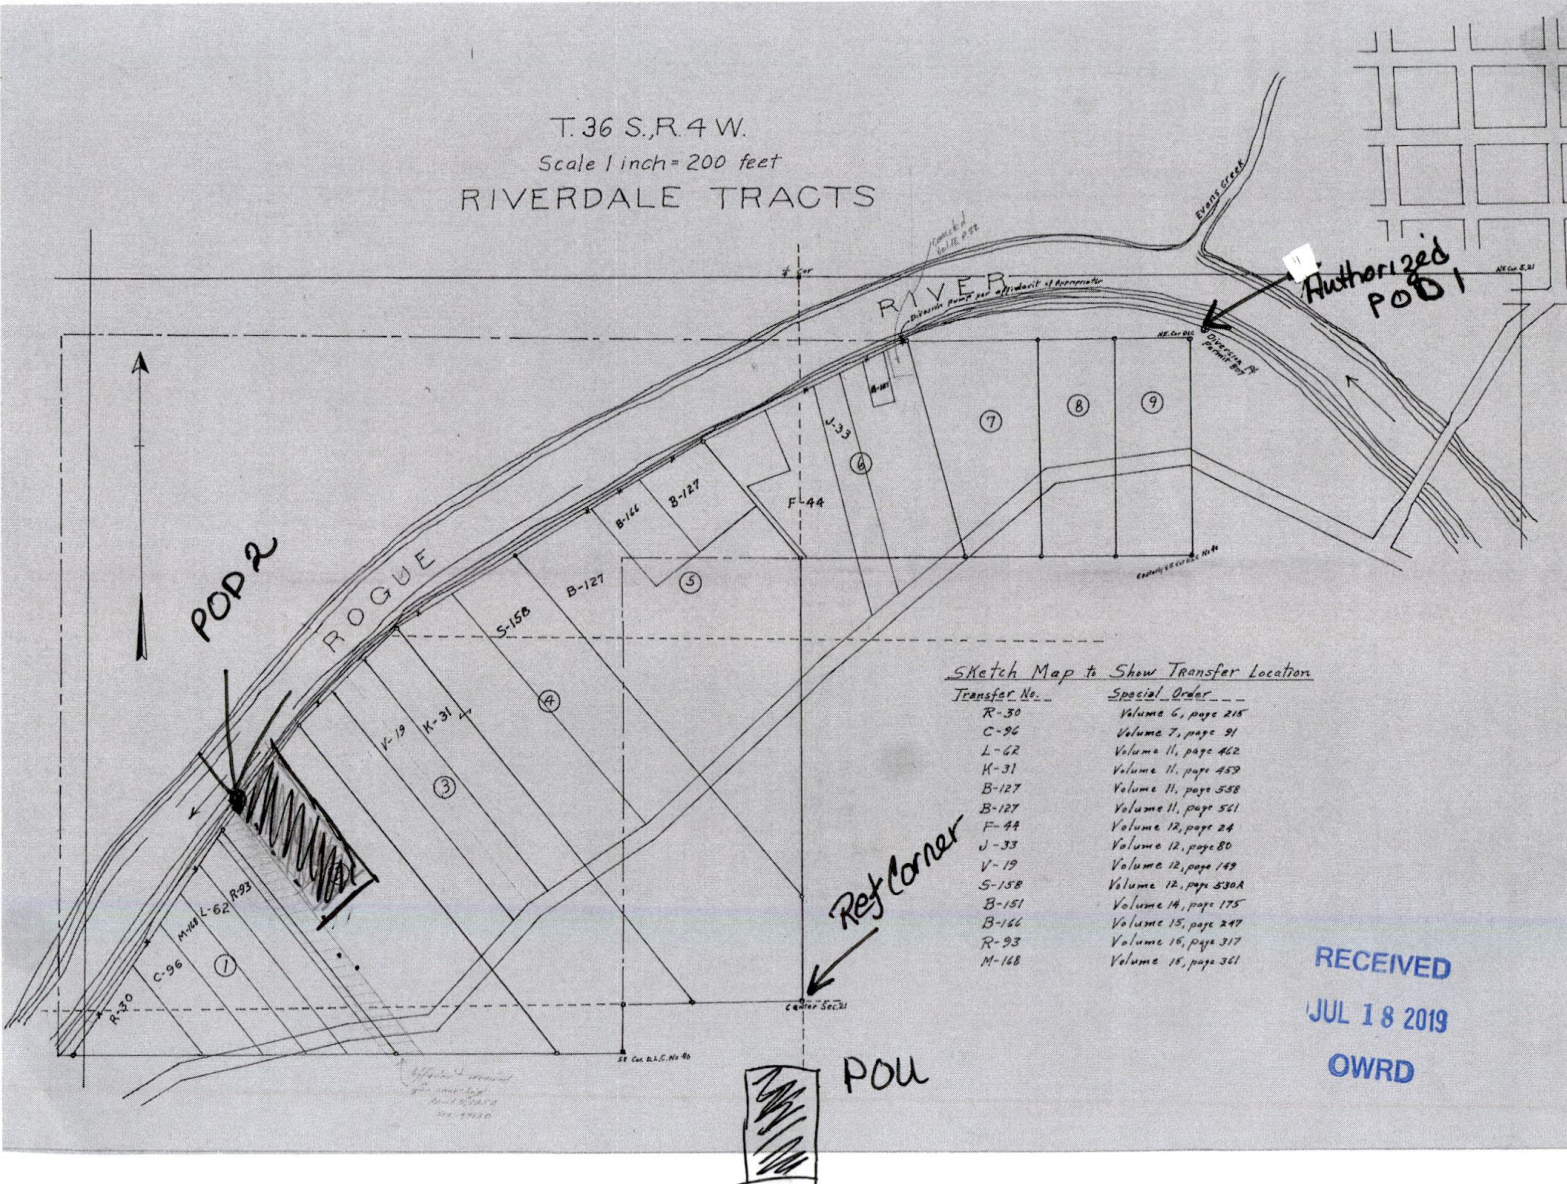

Sketch Map to Show Transfer Location

| Transfer No. | Special Order |
|--------------|----------------------|
| R-30 | Volume 6, page 215 |
| C-96 | Volume 7, page 51 |
| L-62 | Volume 11, page 462 |
| K-31 | Volume 11, page 459 |
| B-127 | Volume 11, page 538 |
| B-127 | Volume 11, page 561 |
| F-44 | Volume 12, page 24 |
| J-33 | Volume 12, page 80 |
| V-19 | Volume 12, page 142 |
| S-158 | Volume 12, page 830A |
| B-151 | Volume 14, page 175 |
| B-166 | Volume 15, page 249 |
| R-93 | Volume 15, page 317 |
| M-168 | Volume 15, page 351 |

RECEIVED
 JUL 18 2019
 OWRD

POU

