


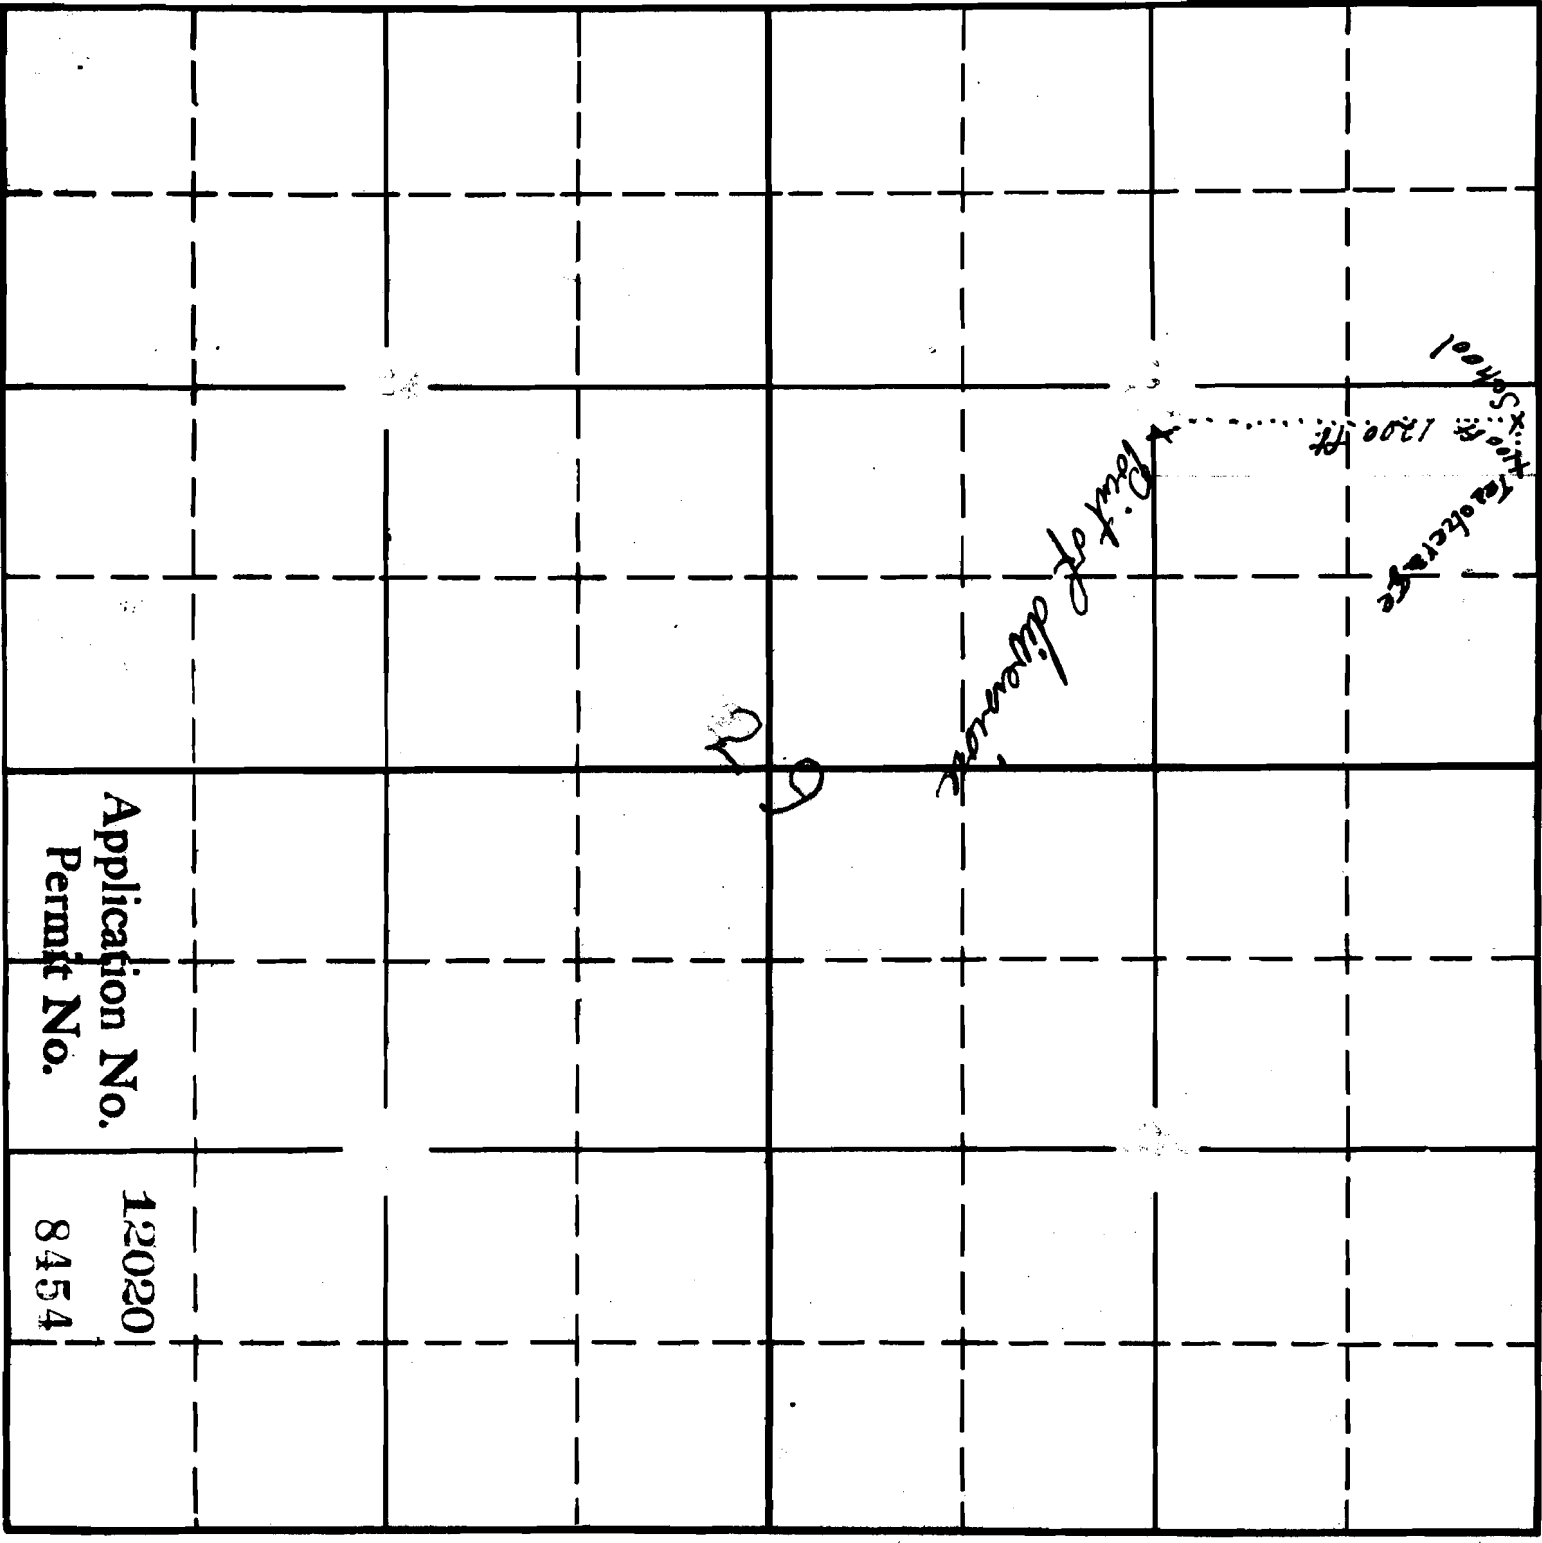

Application No.
Permit No.

12020
8454

Sec. _____
Tp. _____
R. _____
29
5N.
2W.