1" = 400'

RECEIVED BY OWRD

SEP 24 2012

SALEM, OR

Certified Water Right Examiner
033
Gary L. Dolarnett
Nov. 19, 1987
STATE OF OREGON

CROOK COUNTY, OREGON

TOWNSHIP 16 SOUTH
RANGE 14 EAST,
WILLAMETTE MERIDIAN

SECTION 3 (TAX LOT 400)
GOV LOT 1 0.5 IRRIGATED ACRES

APPLICATION G-16483 PERMIT G-16159

RENEWAL DATE: 12-31-2013

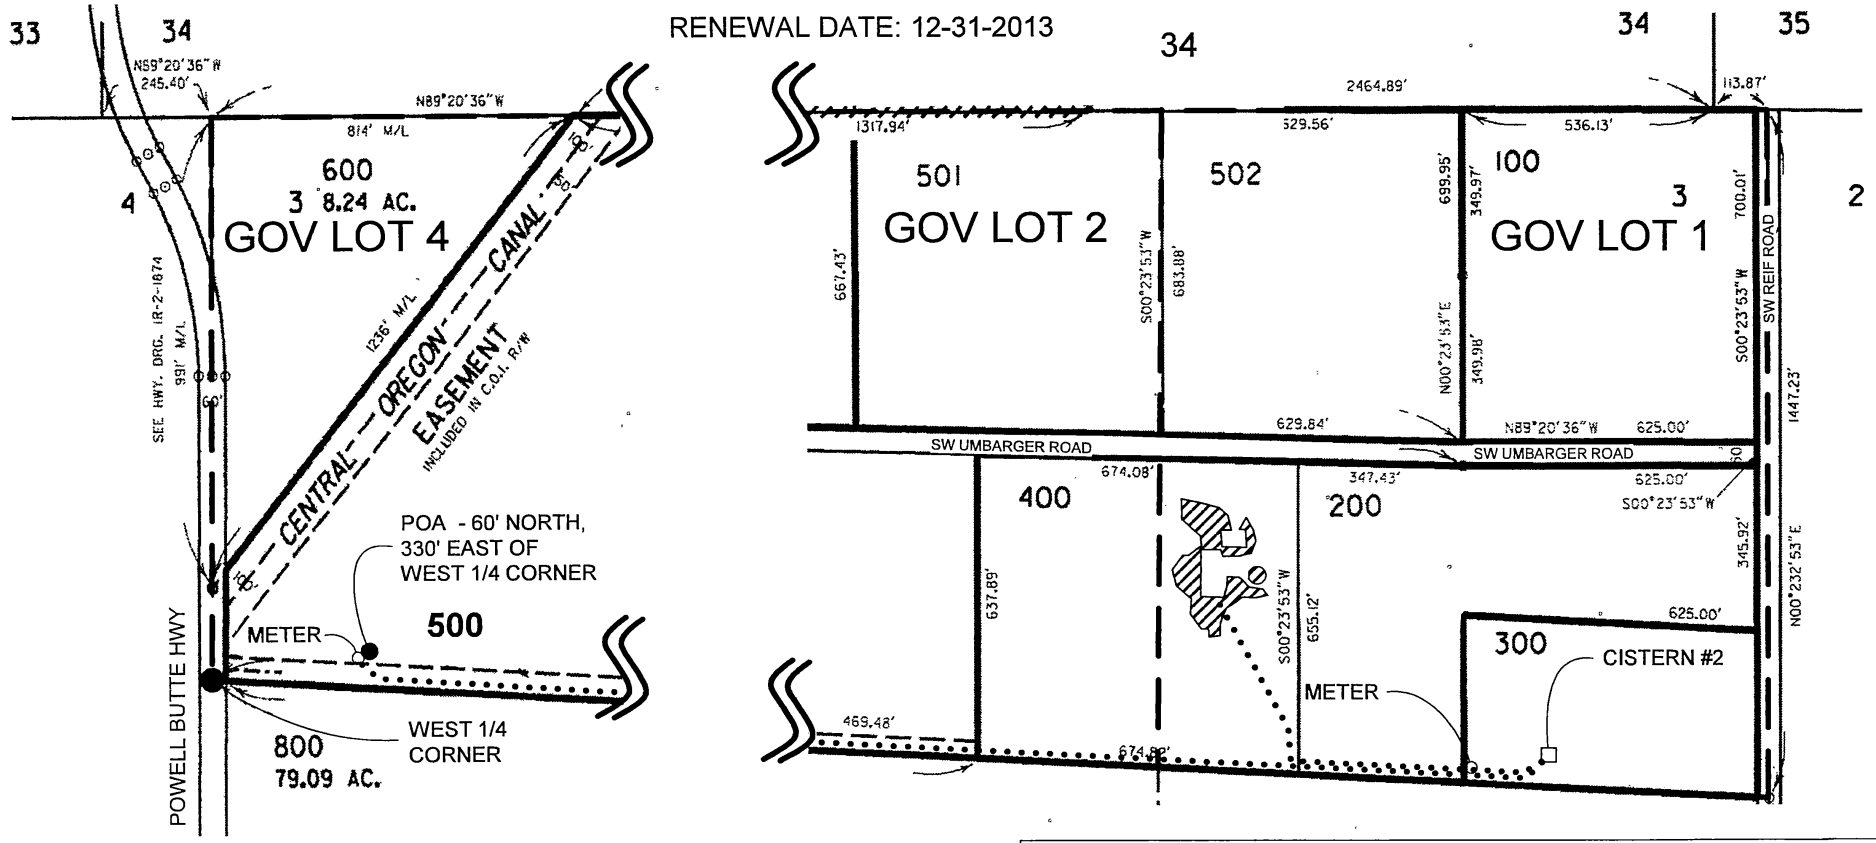

POU - IRRIGATION

BURIED PIPELINE

QUARTER QUARTER OR GOVERNMENT LOT BOUNDARY

NOTE: THIS MAP IS NOT INTENDED TO PROVIDE LEGAL DIMENSIONS OR LOCATIONS OF PROPERTY OWNERSHIP LINES.

TITLE

CLAIM OF BENEFICIAL USE MAP for SCOTT C. & CECELIA Y. GRANGER

WATER RIGHT SERVICES, LLC WWW.OREGONWATER.US
P.O. BOX 1830, BEND OR 97709 (541) 389-2837 CCB# 197121

DATE		JOB#
SEPT 17, 2012	JOHNSHORT@USA.COM	12049