


FINAL PROOF SURVEY MAP
 IN THE NAME OF LOSHBAUGH INCORPORATED
 SECTIONS 1 & 12, TOWNSHIP 30 SOUTH, RANGE 15 WEST, W.M.

APPLICATION 71114


PERMIT 51445

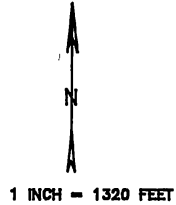

RECEIVED

SEP 2, 1995

WATER RESOURCES DEPT.
 SALEM, OREGON

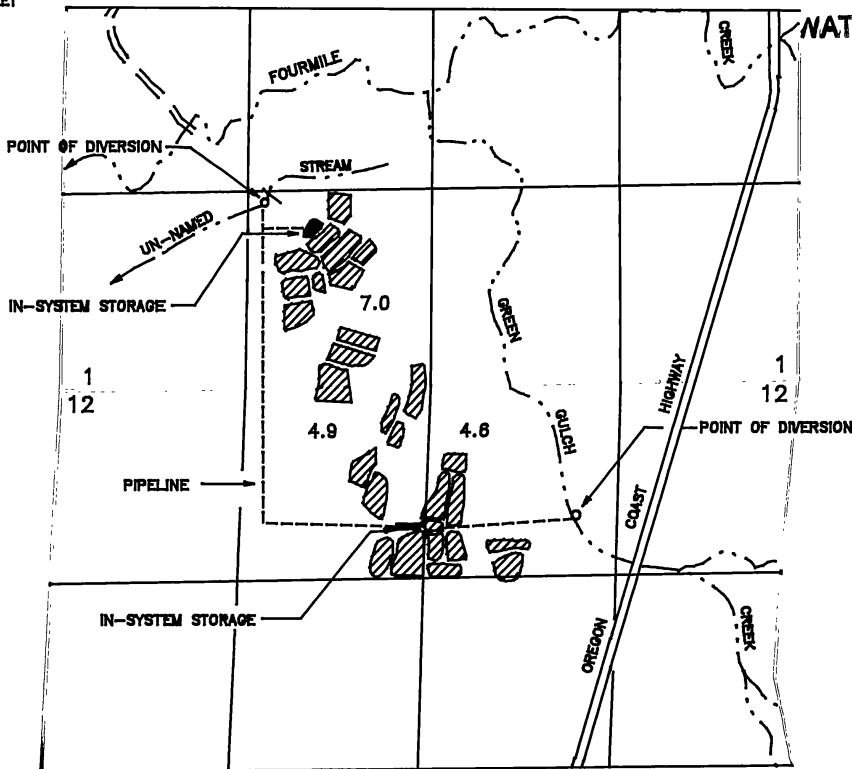

POINT OF DIVERSION FROM THE UN-NAMED STREAM IS LOCATED 1240 FEET NORTH AND 1180 FEET WEST FROM THE NORTH 1/4 CORNER OF SECTION 12, BEING WITHIN THE SOUTHEAST 1/4 OF THE SOUTHWEST 1/4 OF SECTION 12.

POINT OF DIVERSION FROM GREEN GULCH CREEK IS LOCATED 840 FEET SOUTH AND 1000 FEET EAST FROM THE NORTH 1/4 CORNER OF SECTION 12, BOTH BEING IN TOWNSHIP 30 SOUTH, RANGE 15 WEST, W.M., COOS COUNTY.

THE PURPOSE OF THIS MAP IS TO IDENTIFY THE LOCATION OF THE WATER RIGHT. IT IS NOT INTENDED TO PROVIDE INFORMATION RELATIVE TO THE LOCATION OF PROPERTY OWNERSHIP BOUNDARY LINES.

