

Claim of Beneficial Use Map


Larry and Renee Thompson

T 9253





Certificate 34036


T 37 S, R 4 W, Sec 30, W.M.

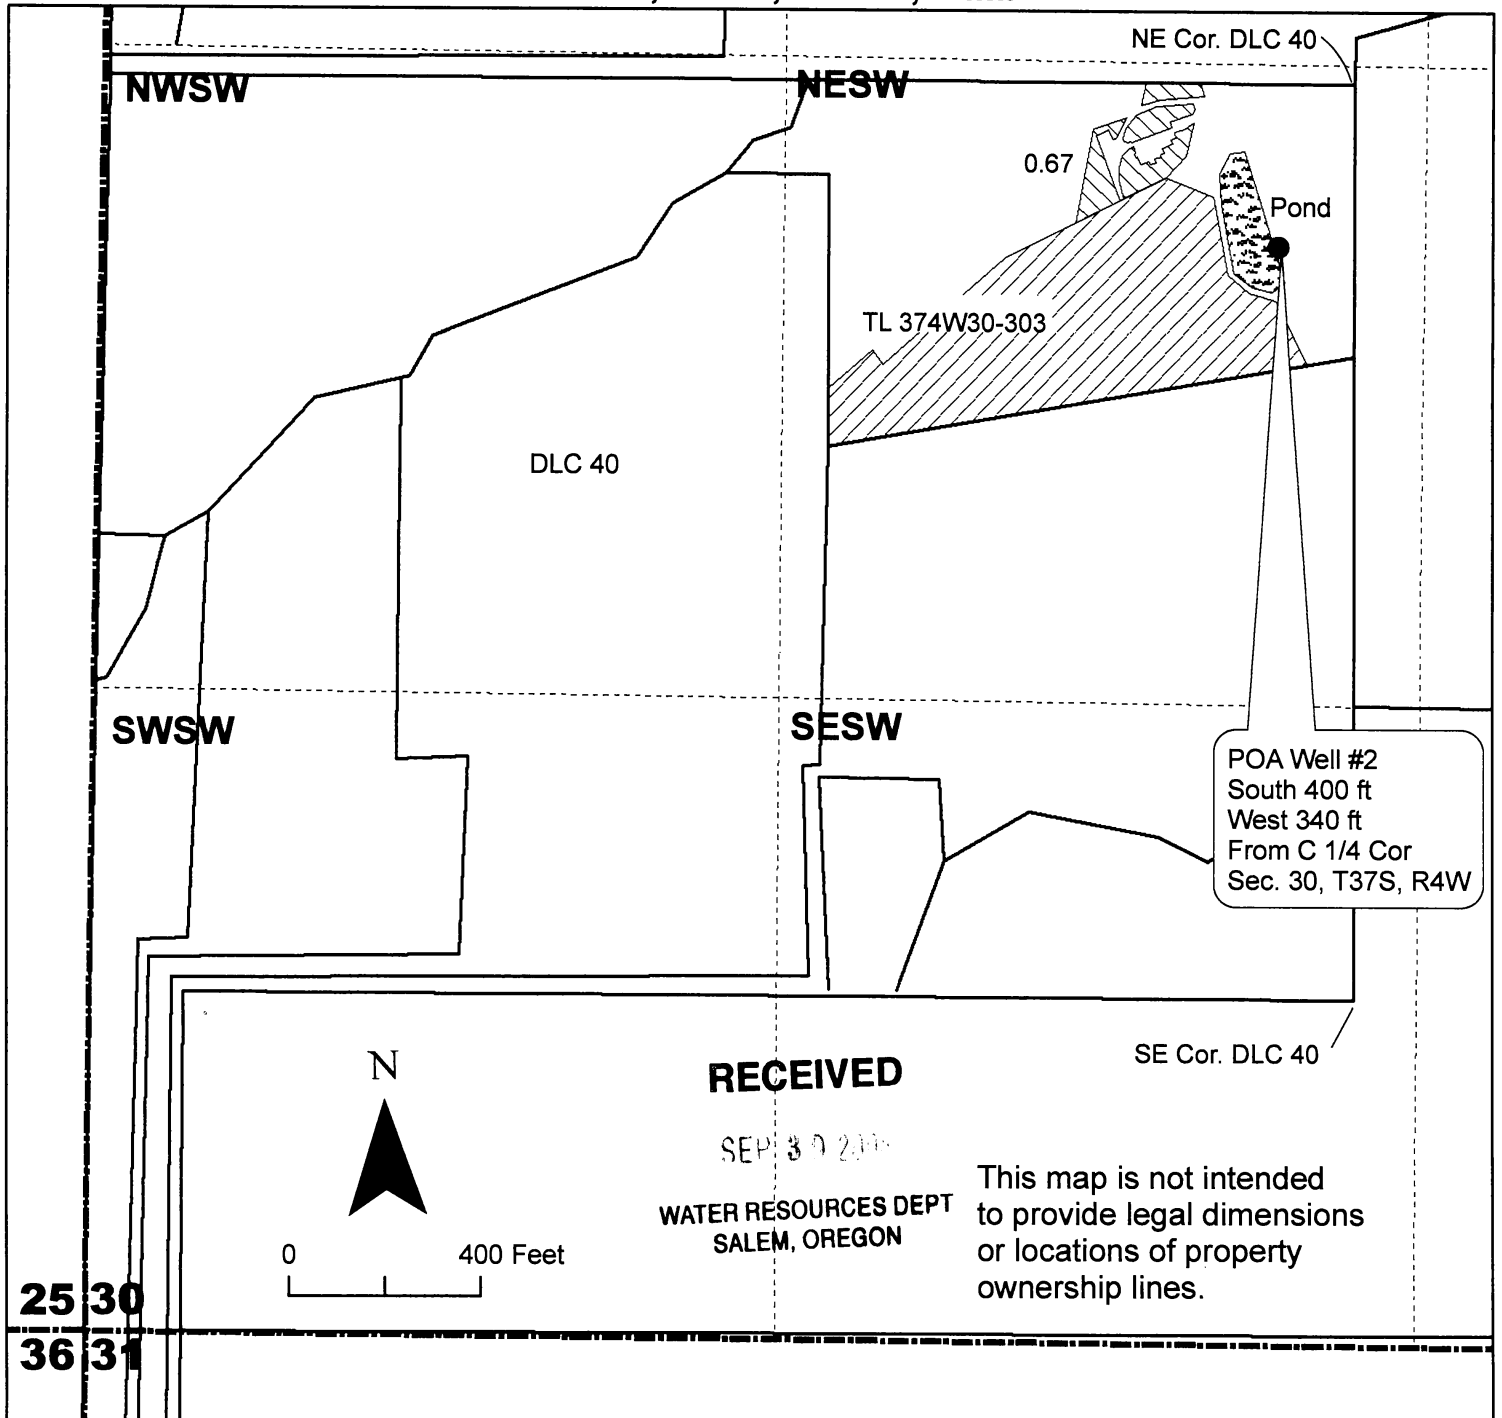Map 1 of 2

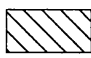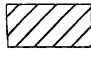

Legend

-  T 9253 COBU irrigated
-  C 81892 Primary C 82272
-  section lines
-  Quarter quarter line

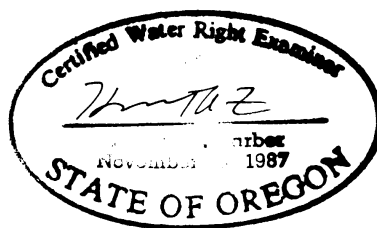

RENEWAL DATE 12-31-09



PO Box 5286
Central Point, Oregon 97502
Phone 541-664-5599
Fax 541-664-5603
Email hfarber@charter.net

Farber & Sons, Inc.
431 Oak Street
Central Point, Oregon
Tax ID: 93-1057173