


CLAIM OF BENEFICIAL USE MAP

FOR: B & B ROADS, INC
 BY: NATHAN R. REED, P.E., CWRE
 T28S, R7W, W.M. SECTION 2, GLOT 6
 APPLICATION NO. S-88158
 PERMIT NO. S-54993
 DATE SURVEYED: DECEMBER 9, 2016

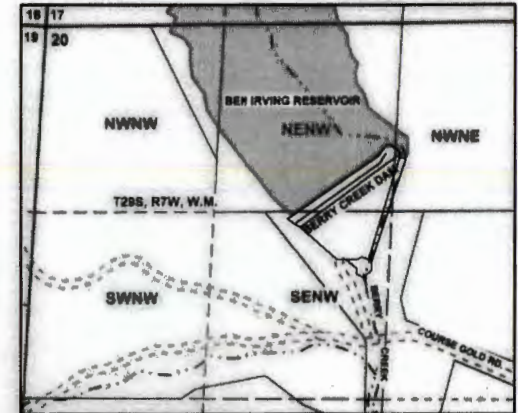

SCALE: 1" = 1320'
 POD IS LOCATED 944 FEET NORTH AND
 266 FEET WEST FROM THE C1/4 CORNER,
 SECTION 20.

Legend

- POD
- ▼ Pump
- Ⓜ Meter
- Main Line
- Structures
- ⋯ Drive/Road
- - - Stream
- Flow Arrow
- ▒ Reservoir
- - - - - Gov Lot
- DLC
- Section
- - - - - Quarter
- - - - - Sixteenth
- Parcels

POD IS LOCATED 1526 FEET SOUTH AND 515 FEET WEST FROM C1/4, SECTION 2.

THE PURPOSE OF THIS MAP IS TO IDENTIFY THE LOCATION OF THE WATER RIGHT. IT IS NOT INTENDED TO PROVIDE INFORMATION RELATIVE TO THE LOCATION OF PROPERTY OWNERSHIP BOUNDARY LINES.

MAP PREPARED FOR:
 B & B ROADS, INC
 1086 DAIRY LOOP ROAD
 ROSEBURG, OR 97471

MAP PREPARED BY:
 NATHAN R. REED, P.E., CWRE
 1113 SE CASS AV
 ROSEBURG, OR 97470