

Google Maps Tenmile Creek Rd

①

↑ 6 MILES TO YACHATS




Imagery ©2019 Google, TerraMetrics, Data SIO, NOAA, U.S. Navy, NGA, GEBCO, Map data ©2019 Google 1000 ft

↓ 20 MILES TO FLORENCE

RECEIVED
MAR 20 2019
OWRD

SEE MAP ②

POINT OF DIVERSION/INTAKE

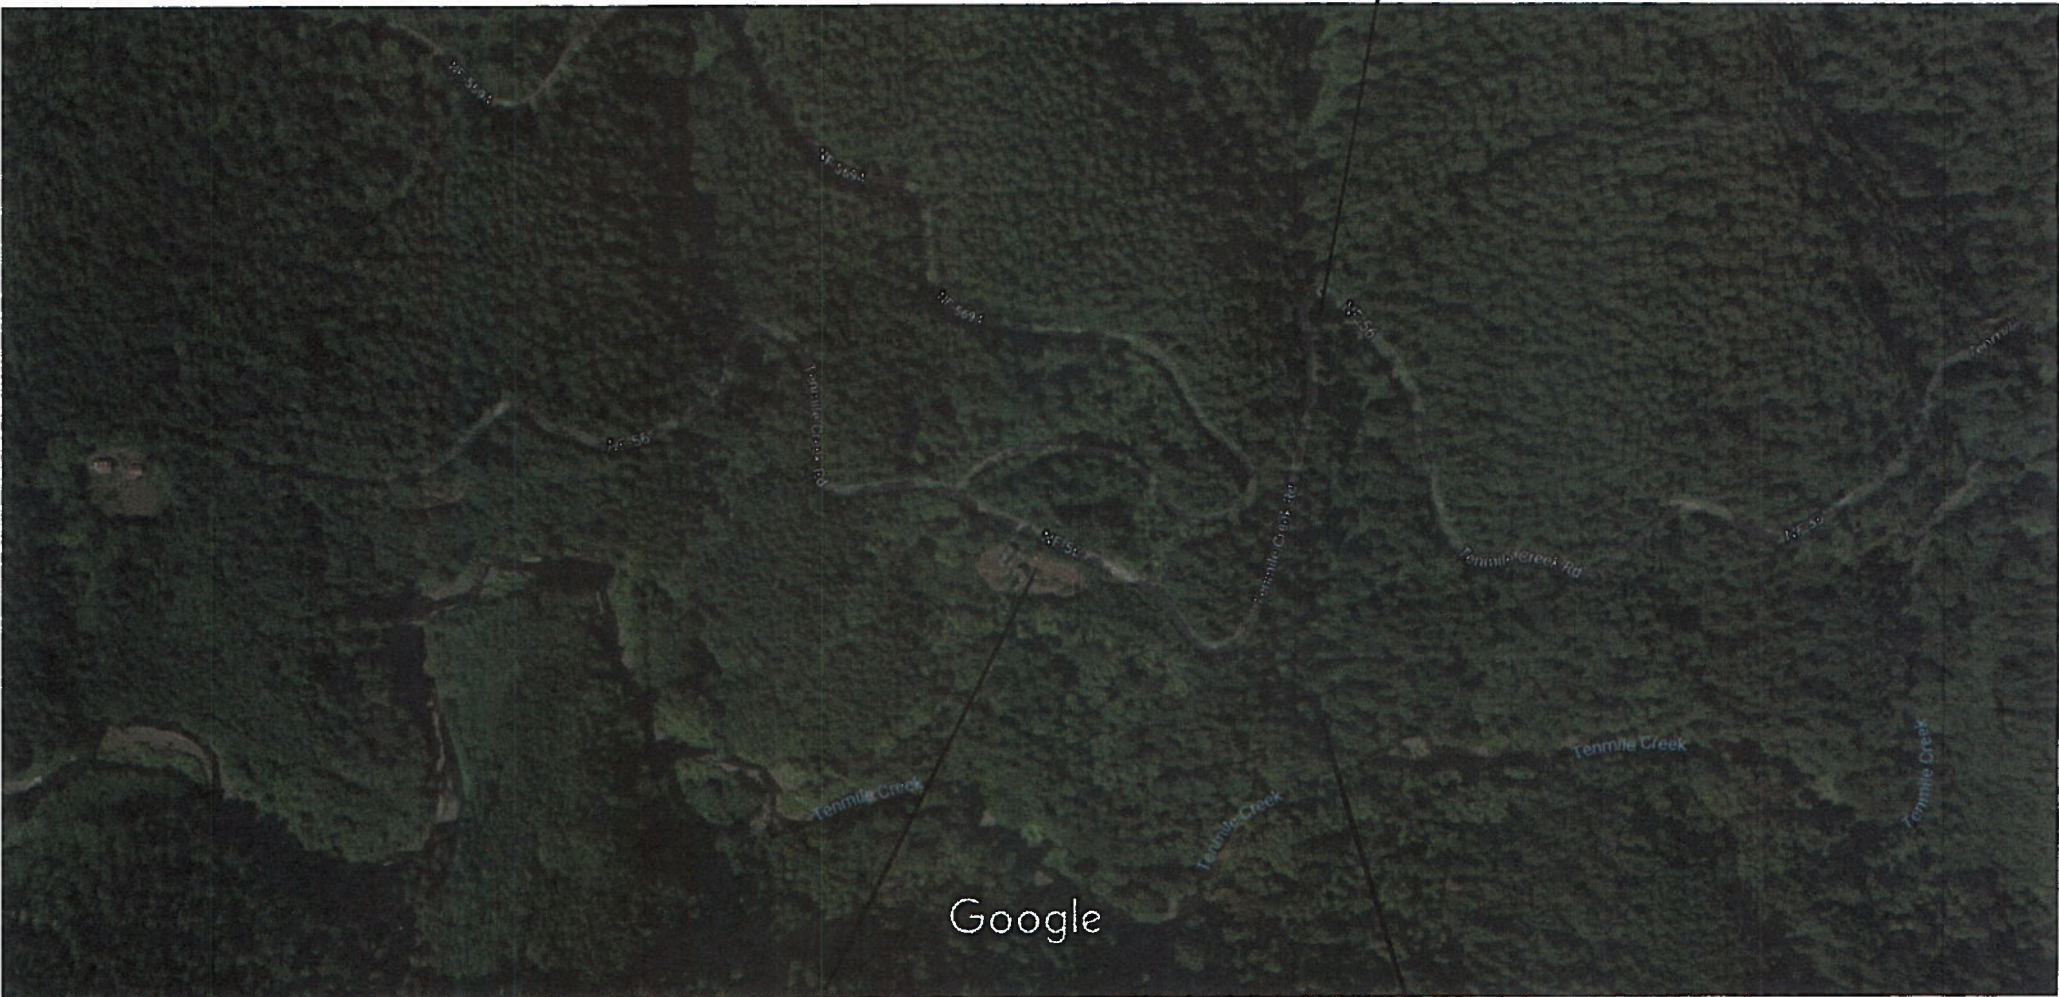

Google

Imagery ©2019 Google, Map data ©2019 Google 200 ft

RESIDENCE
6340 TENMILE CK RD
YACHATS OR 97498

POWER SITE

RECEIVED

MAR 20 2019

OWRD