


T.23S., R. 37E., W.M.

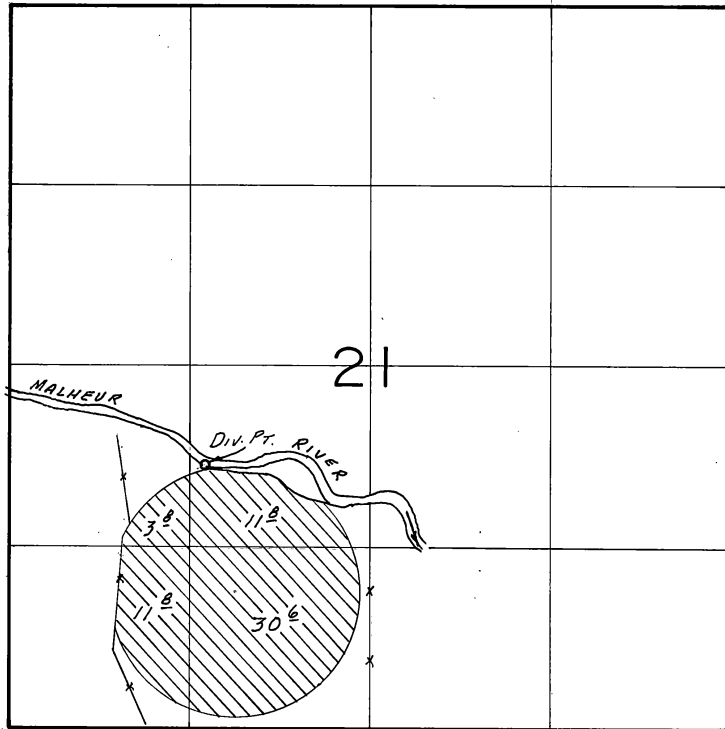

DIV. PT. LOC.: 740'S. & 1420'E. FROM W. 1/4 COR. SEC. 21.

SCALE: 1" = 1320'

FINAL PROOF SURVEY
UNDER

Transfer No. 5309

IN NAME OF

FRANK & JEANNINE BETTENCOURT

Surveyed May 19 1986, by L.M.TOLL

3/20/87 BUB
PTS 1986V-A