


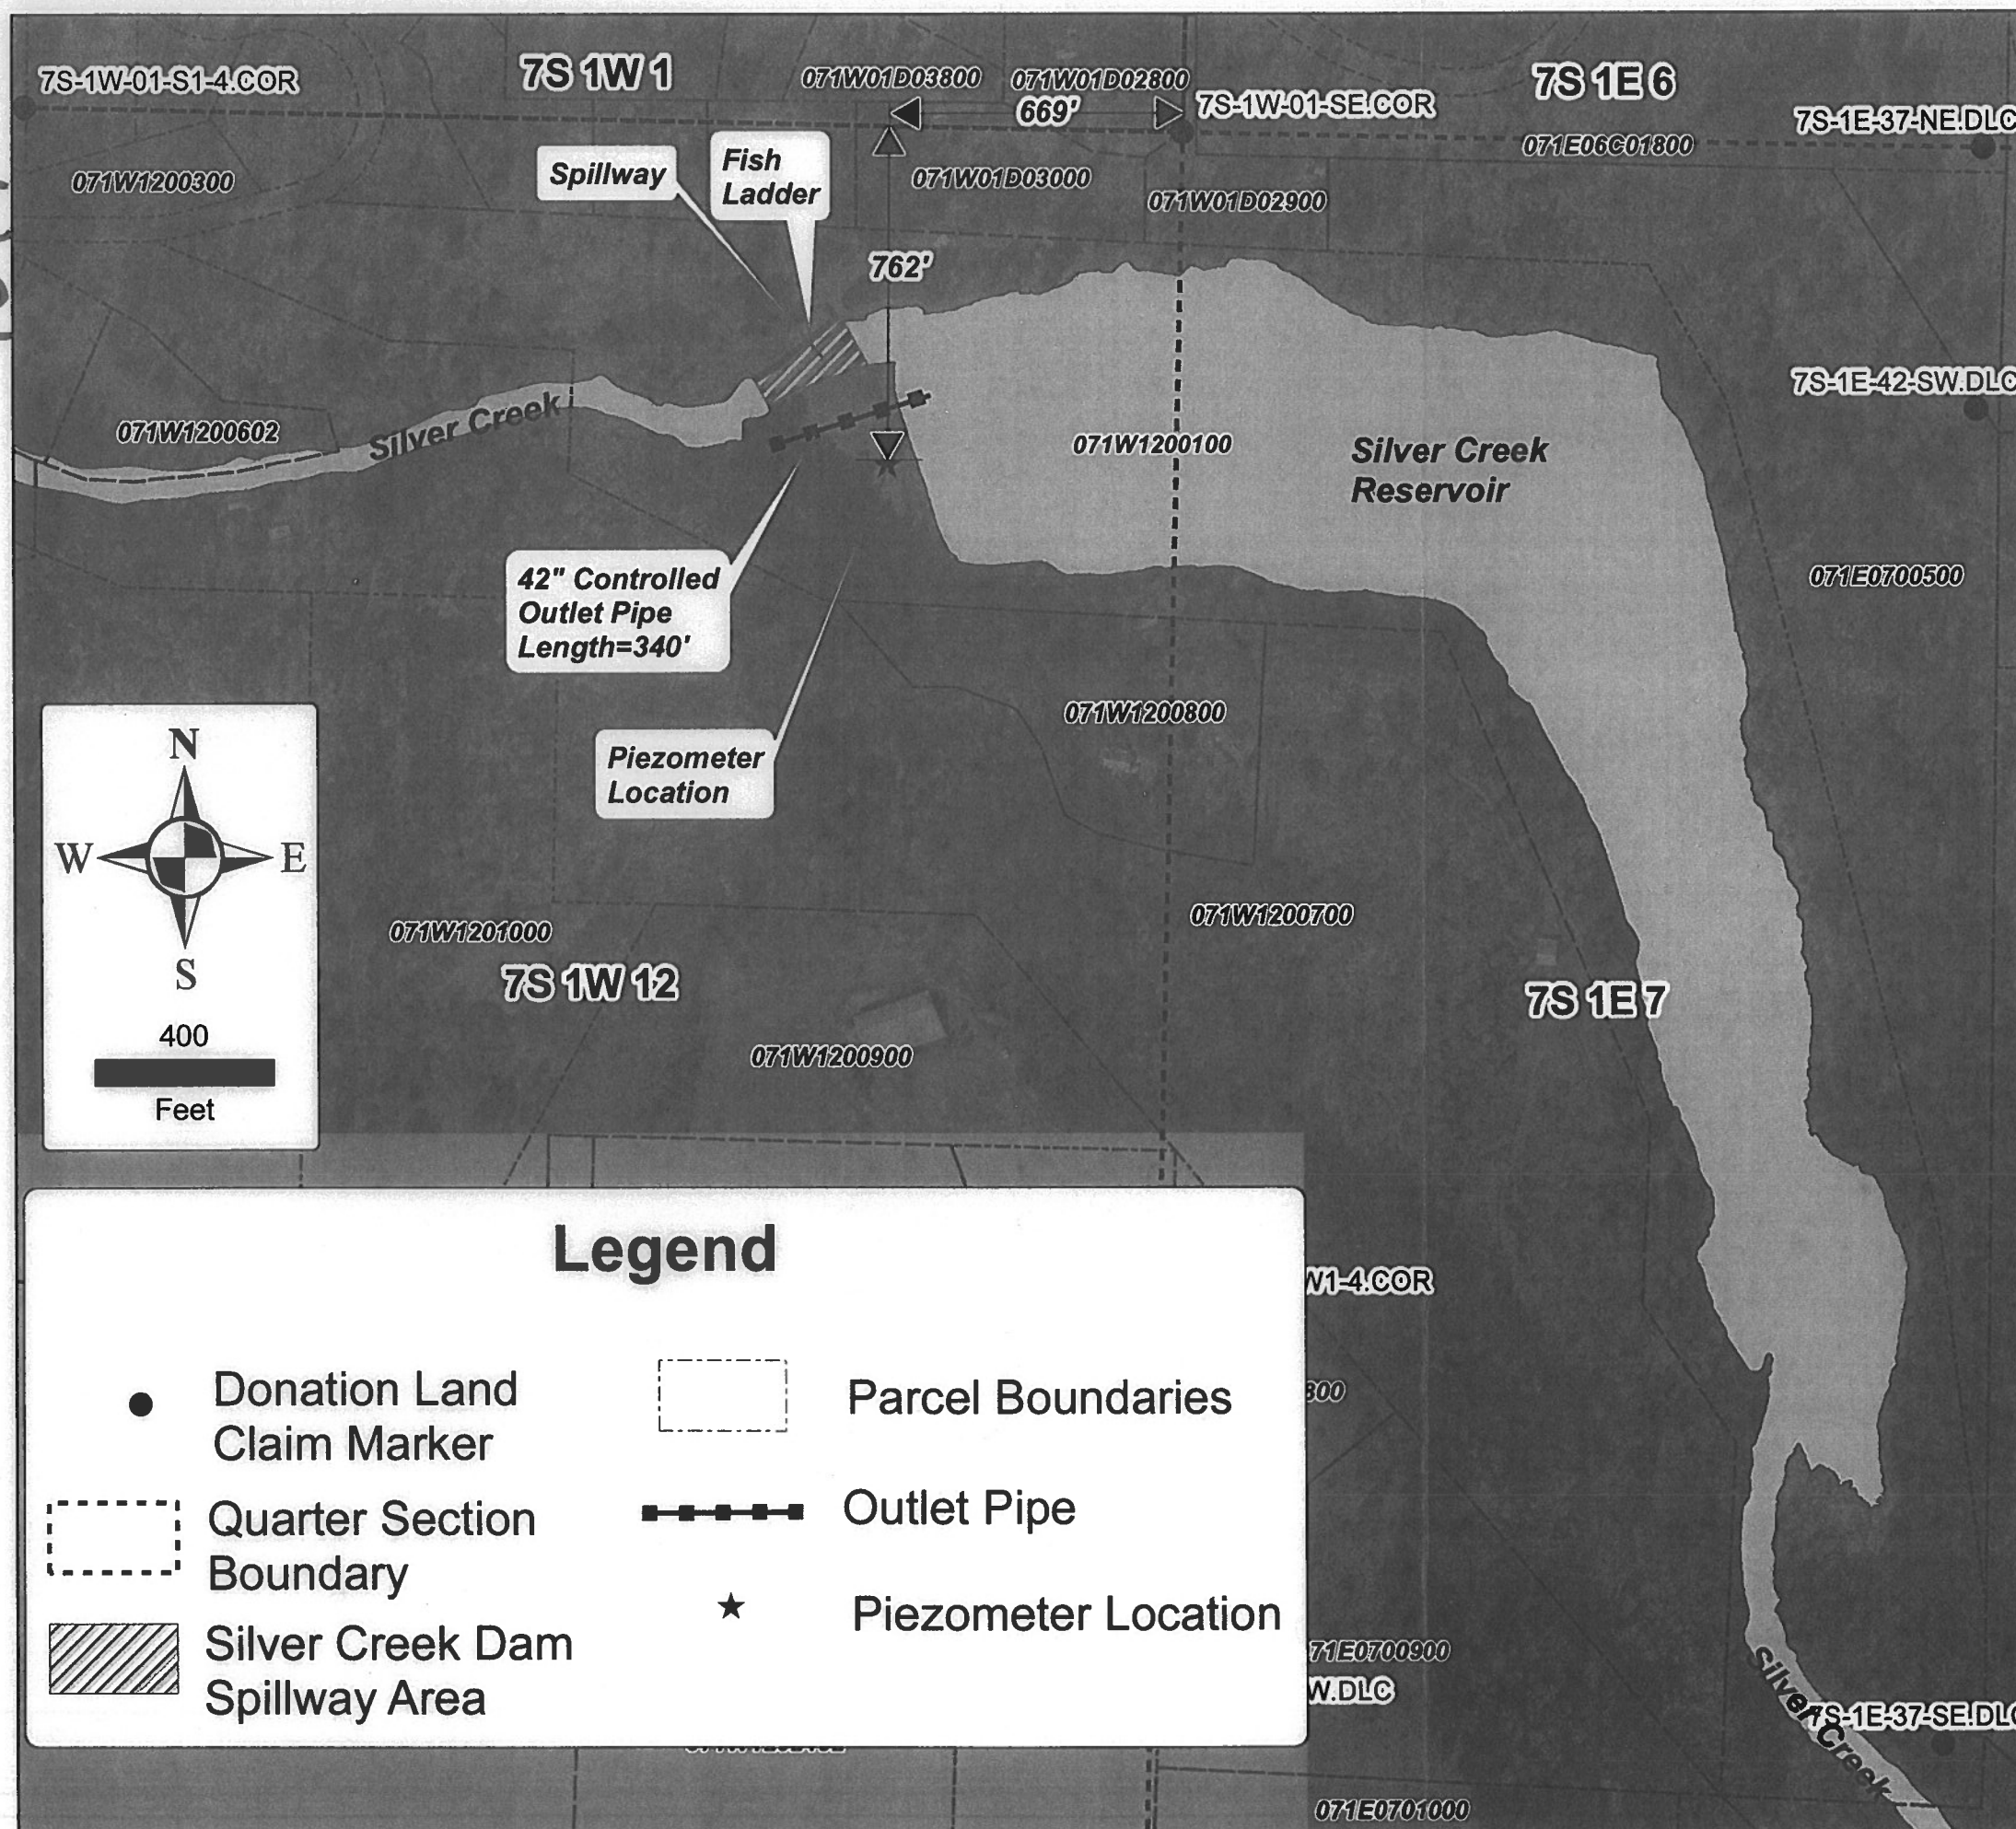


Map to Accompany Claim of Beneficial Use (COBU) for App. R-50184 and Permit R-5948, Section 12, T7S, R1W; and Sections 7 and 18, T7S, R1E, WM, Marion County, Oregon.

NOTES:

- 1) This map is not intended to provide legal descriptions or locations of property ownership lines.
- 2) Map was prepared for the City of Silverton Public Works Department, 306 S. Water Street, Silverton, OR 97381.
- 3) Map prepared by :
Paul Eckley, CWRE#415WRE
306 S. Water Street
Silverton, OR 97381.
- 4) No Government Lots for POU from Marion County GIS.

Cobu MAP # 1014

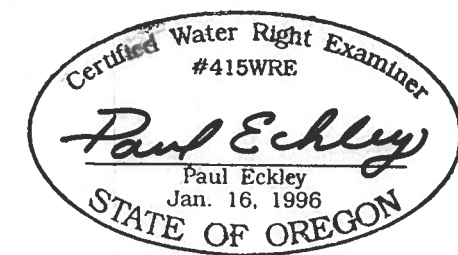

EXPIRES: 12-31-2017

**CITY OF SILVERTON
PUBLIC WORKS
DEPARTMENT**
306 S. WATER STREET
SILVERTON, OREGON
503-873-8679
www.silverton.or.us

RECEIVED

AUG 10 2016

WATER RESOURCES DEPT
SALEM, OREGON

