
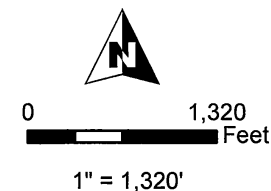


**T21S R21E, WM  
CROOK COUNTY, OR**

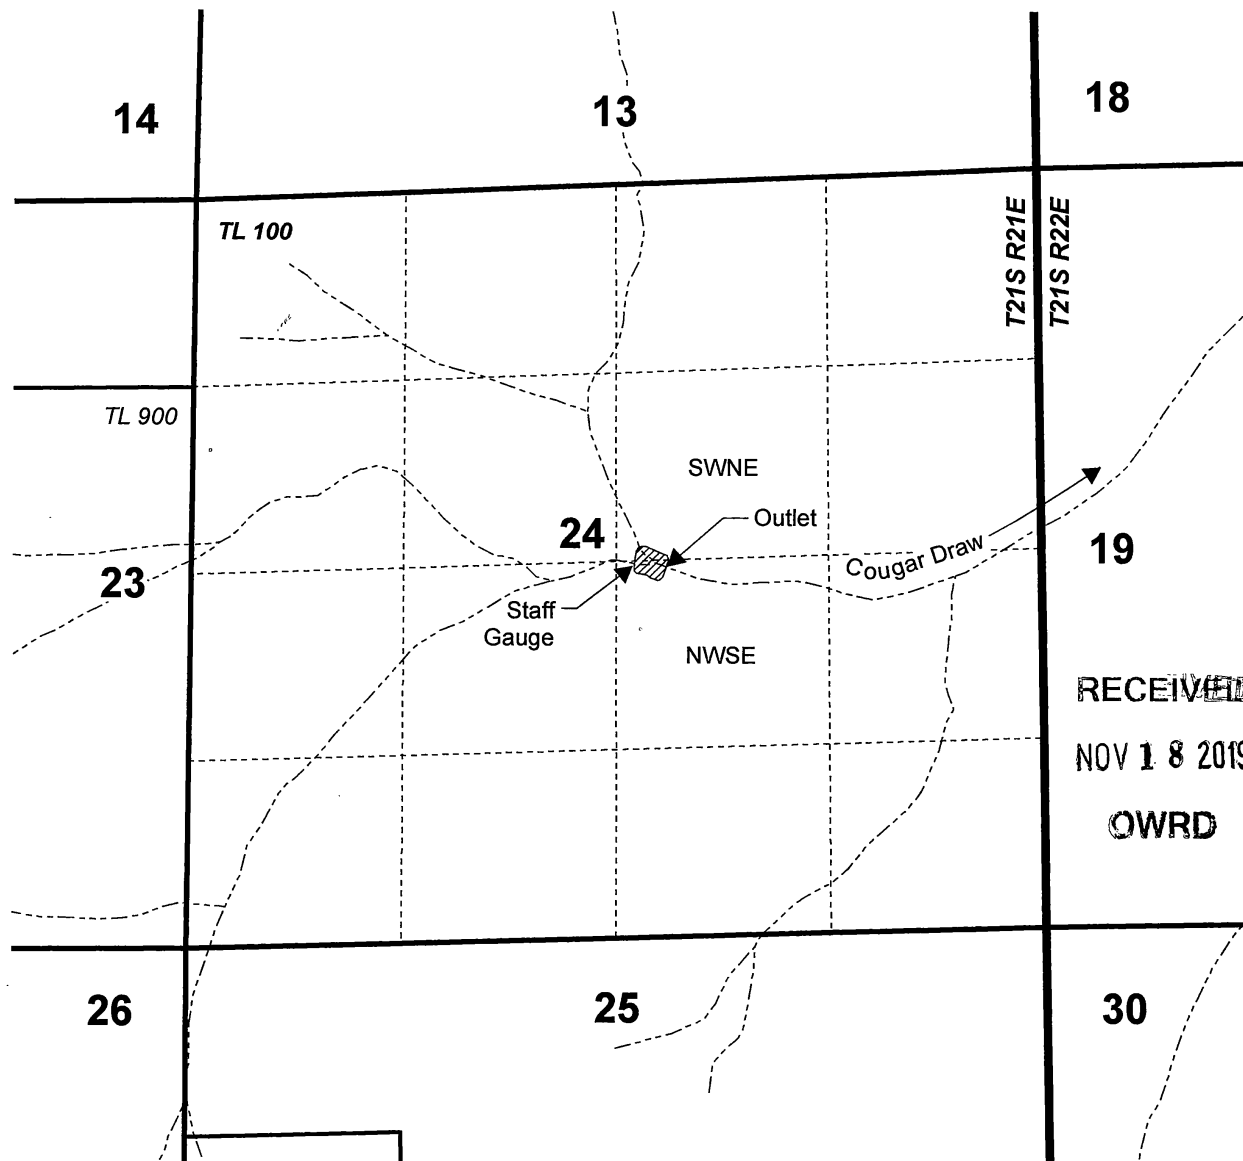

- Creek
- North Cougar Reservoir
- Township
- Section
- Quarter Quarter
- Taxlot

**RECEIVED**  
**NOV 18 2019**  
**OWRD**

Outlet Location: 70' S, 345' E of Cen Sec 24

Staff Gauge Location: 30' S, 200' E of Cen Sec 24



RENEWAL DATE 12/31/2020



**CLAIM OF BENEFICIAL USE MAP**  
**Bureau of Land Management**

Ap R-66079

Permit R-11792

Date: 10/11/2019

This map is not intended  
to provide legal dimensions  
or locations of property  
ownership lines.

**WATER RIGHT SERVICES, LLC**  
PO BOX 1830, BEND, OR 97709  
**WWW.OREGONWATER.US** CCB # 197121  
johnshort@usa.com 541-389-2837