


Claim of Beneficial Use Map

Bobby R. and Billie L. Evans

T-8314

T 40 S, R 18 E, WM
Section 24 & 25

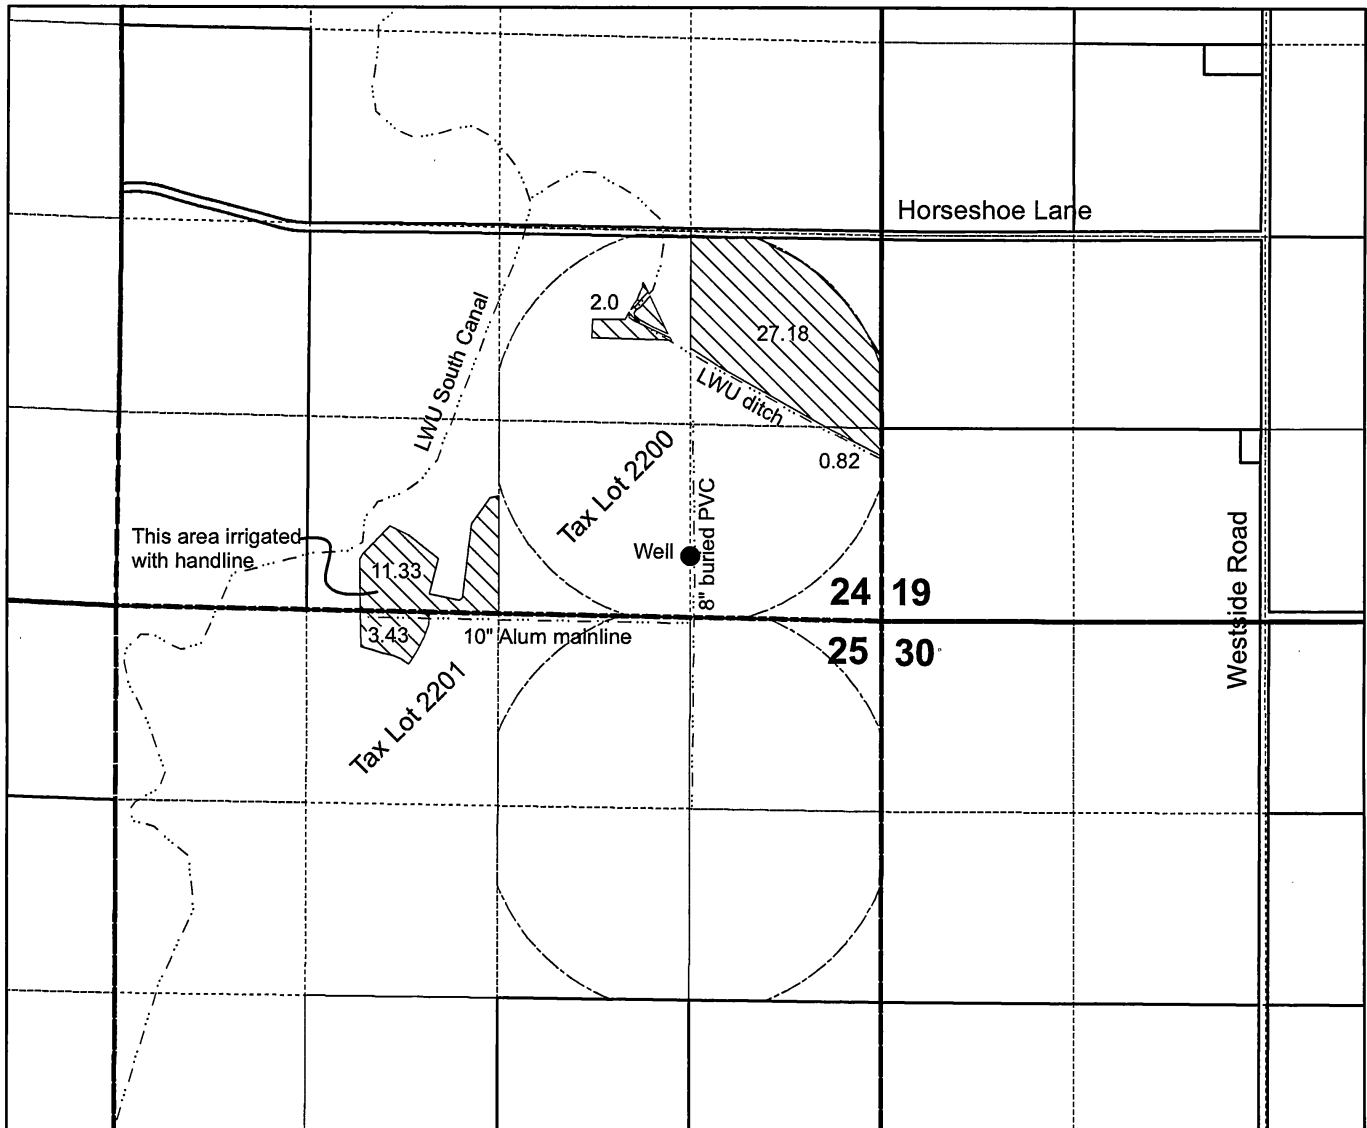

Legend


- Well
- - - LWU ditch
- Pivots
- ▨ T-8314 used

RECEIVED

DEC 09 2019

OWRD

Well is located
400 ft North & 1300 ft West
From SE Cor. Sec 24, T40S, R18E

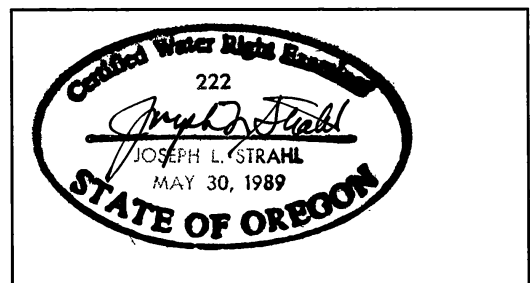

N



1 inch = 1,320 feet

Note: This map is not intended to provide legal dimensions or locations of property ownership lines.