



**T23S, R32 1/2 E,
SECTION 9, WM**


HARNEY COUNTY, OREGON

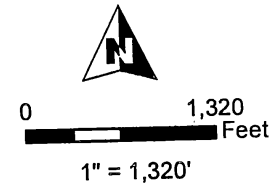

-  POU Irrigation
-  Section
-  Quarter Quarter
-  Taxlot
-  Well

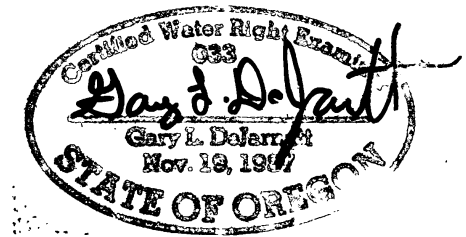

RENEWAL DATE 12/31/2015

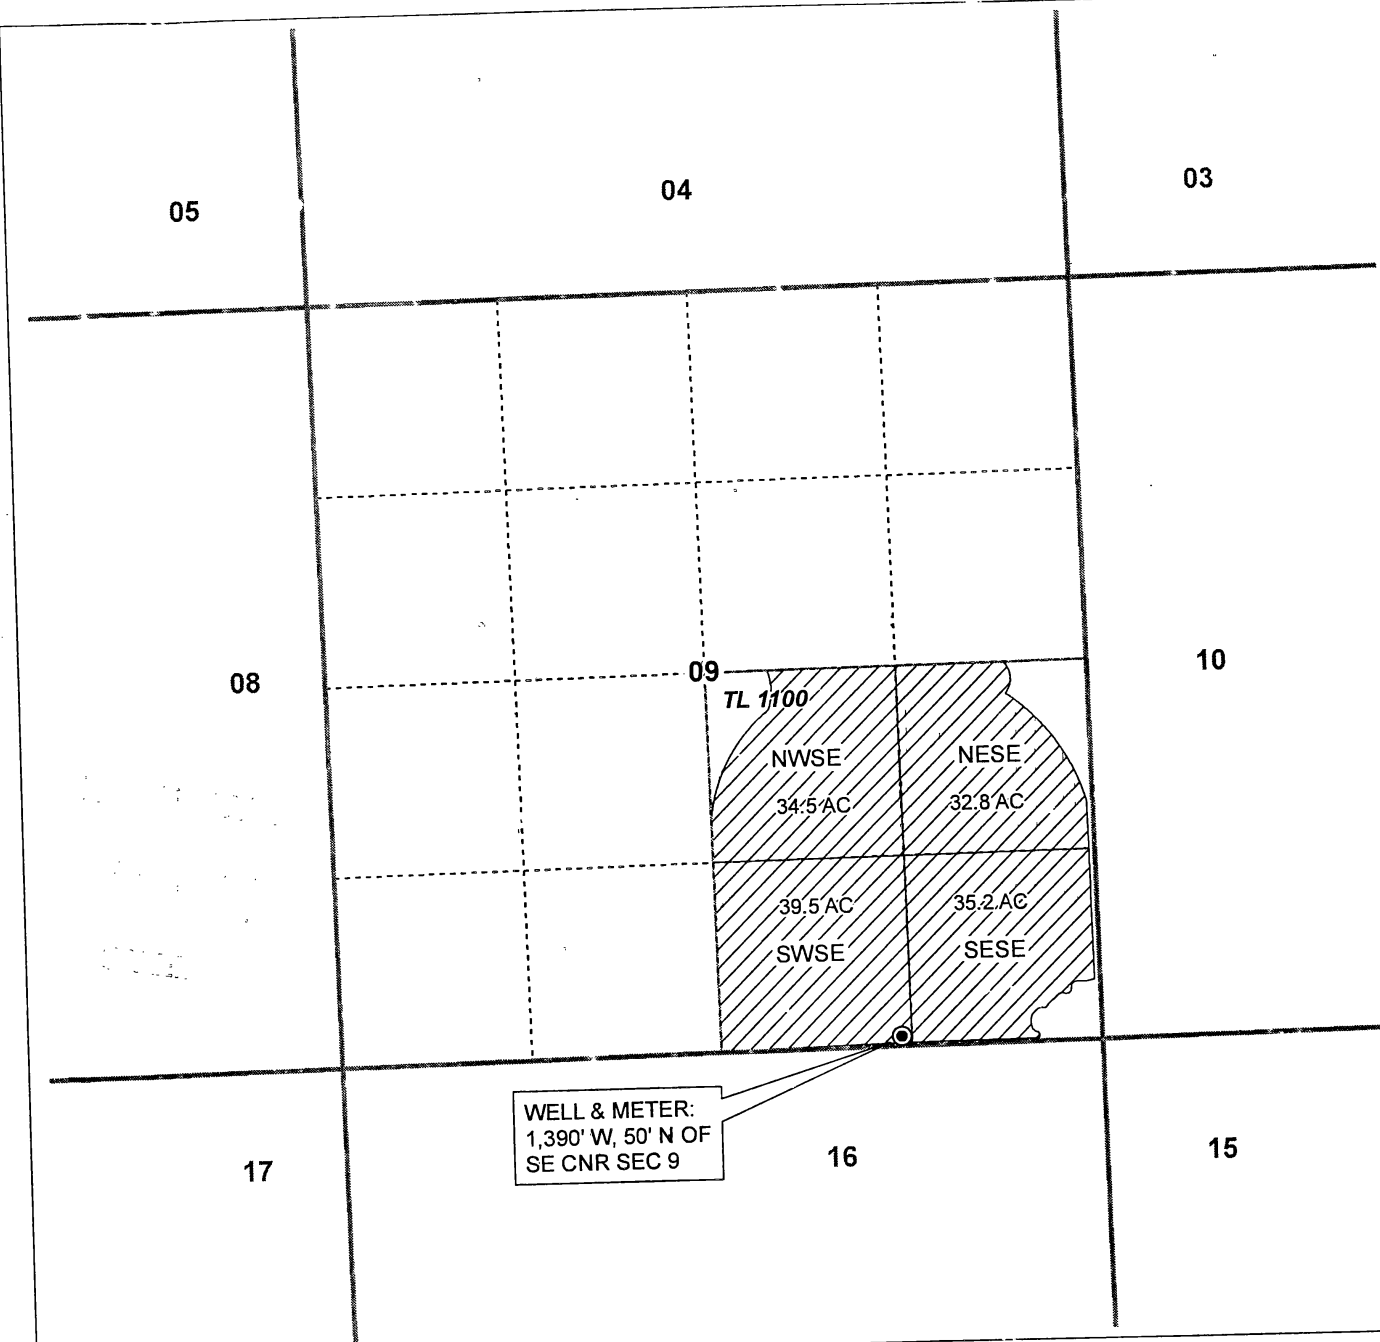

CLAIM OF BENEFICIAL USE MAP
Goertzen

NOTE: THIS MAP IS NOT INTENDED TO
PROVIDE LEGAL DIMENSIONS OR LOCATIONS
OF PROPERTY OWNERSHIP LINES.

WATER RIGHT SERVICES, LLC

PO BOX 1830, BEND, OR 97709

CCB# 197121 www.oregonwater.us

541-389-2837 JOHNSHORT@USA.COM

AP G-16820

PERMIT G-16322

PROJECT #14095

JANUARY 9, 2015