



RENEWAL DATE 12/31/2021

- POD & Fishscreen
- Rivers & Creeks
- Pipeline
- ▨ POU IR
- Section
- Quarter Quarter
- Tax Lot

T40S R3W, WM, JACKSON COUNTY, OR

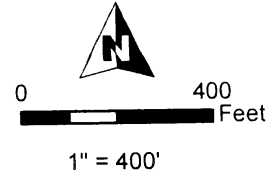

POD Location:
2350' S, 2150' W of E 1/4 Cor Sec 18

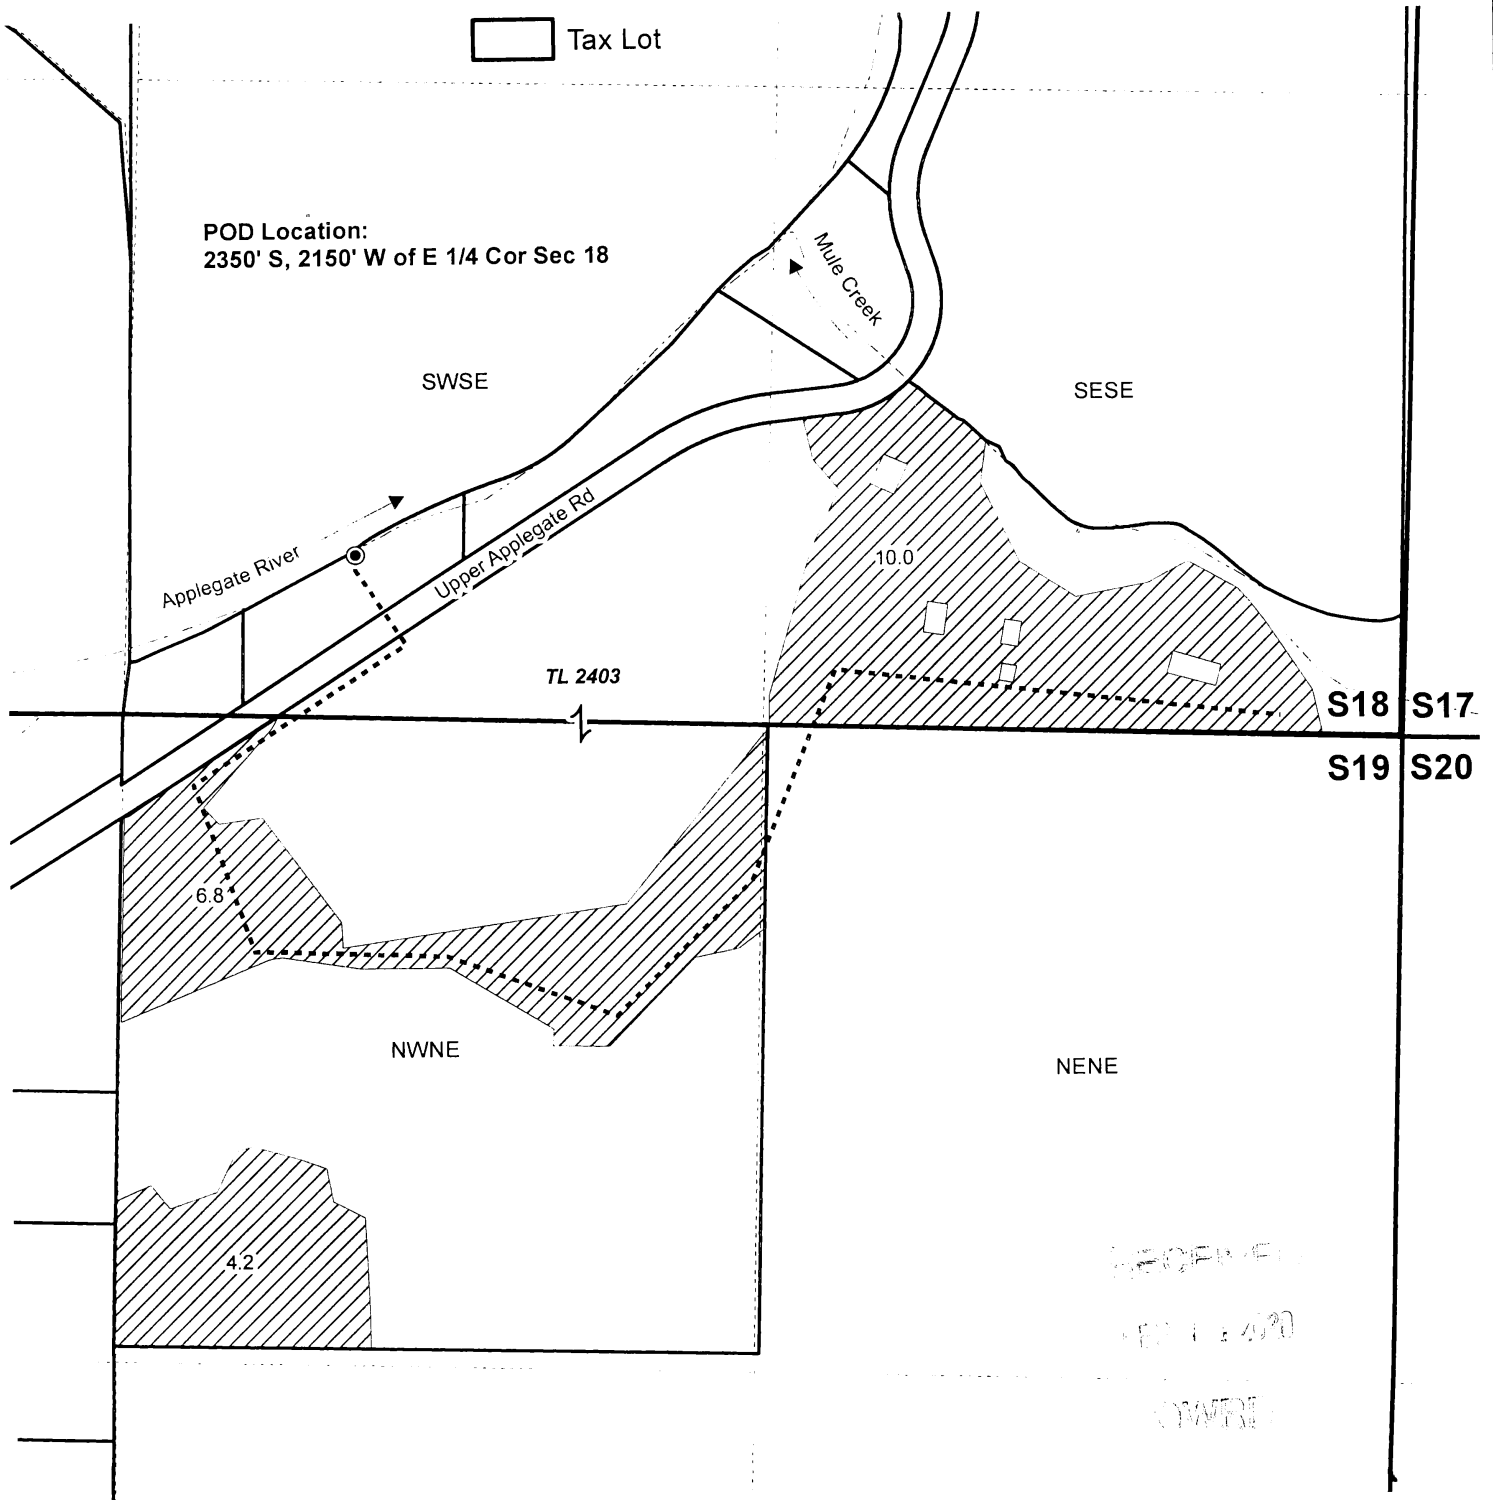

RECEIVED
FEB 11 2020
COWRI

CLAIM OF BENEFICIAL USE MAP Lloyd M. Haines

Ap S-87308
Permit S-54534 Project #19050 Date: 1/20/2020

This map is not intended to provide legal dimensions or locations of property ownership lines.

WATER RIGHT SERVICES, LLC
PO BOX 1830, BEND, OR 97709
WWW.OREGONWATER.US CCB # 197121
johnshort@usa.com 541-389-2837