
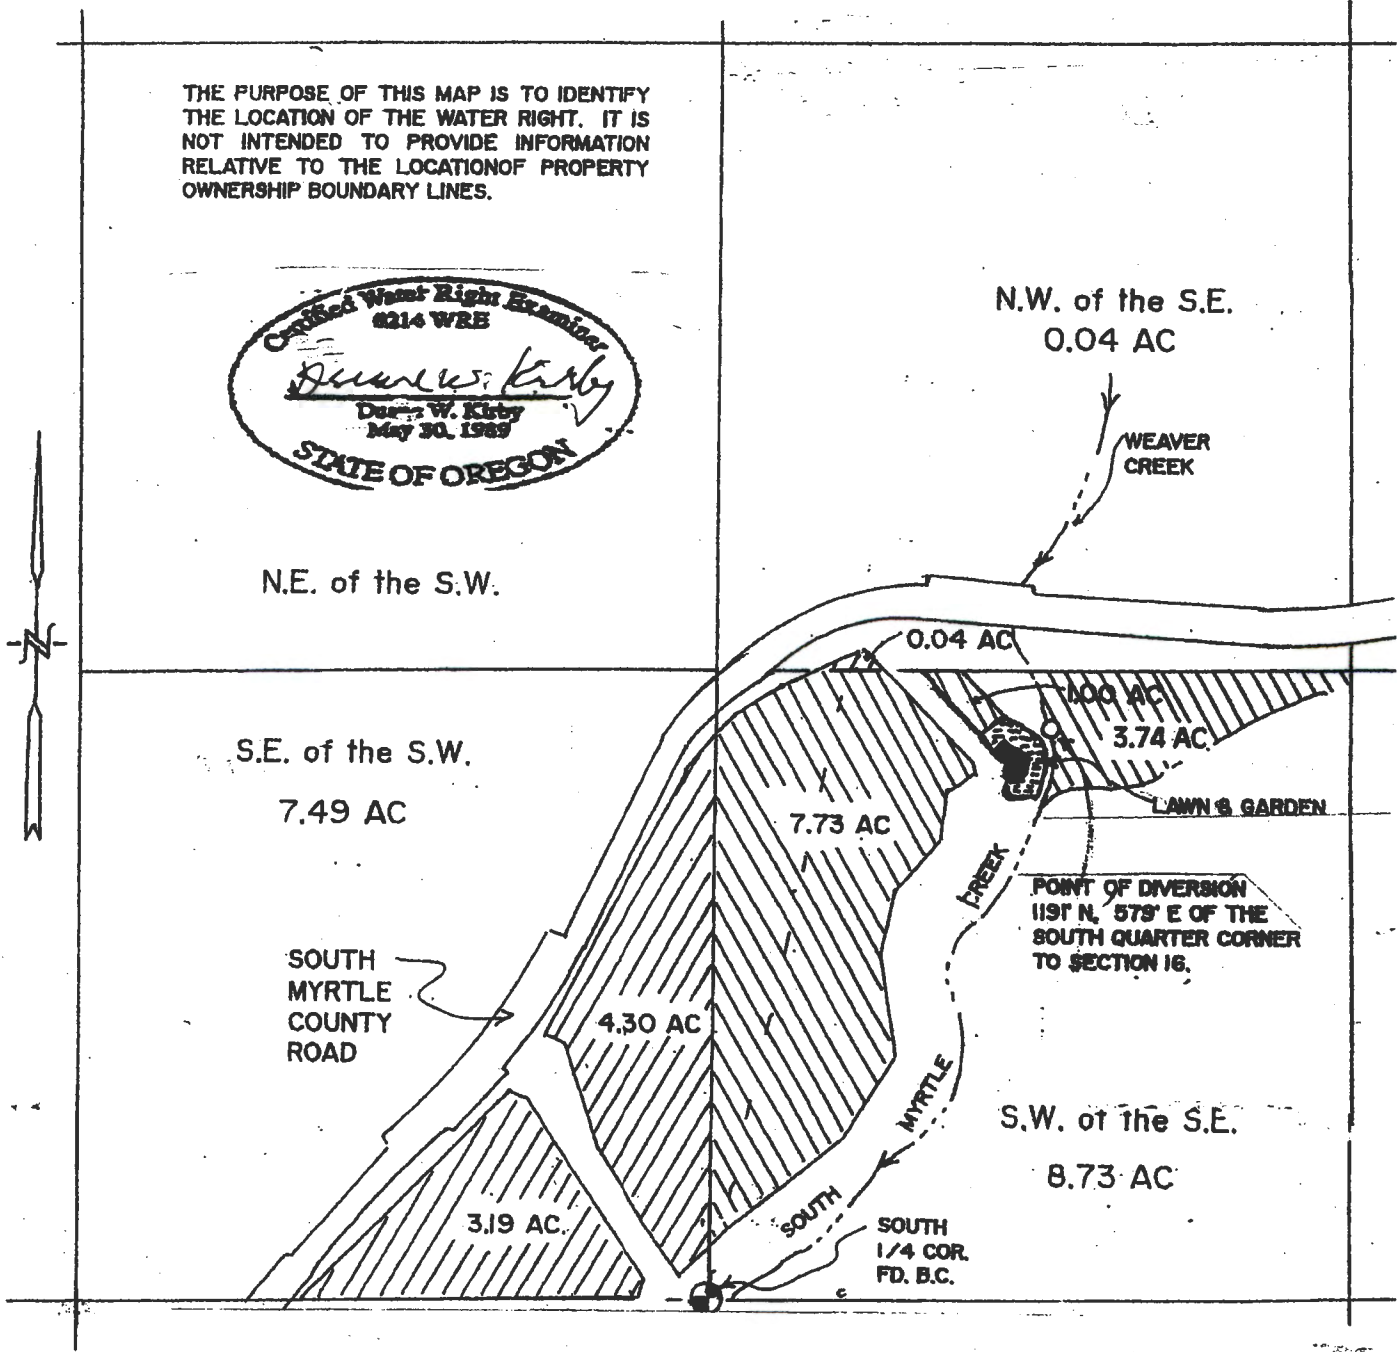


CLAIM OF BENEFICIAL USE  
 FOR ROBERT AND DEBORAH KELLER  
 BY DUANE W. KIRBY  
 SOUTH 1/4 SECTION 16, T29S, R3W, WM  
 T=9586

FISH SCREEN IS AT THE POD  
 METER IS 12' FROM POD  
 TAX LOT 502  
 SCALE 1" = 400'

THE PURPOSE OF THIS MAP IS TO IDENTIFY  
 THE LOCATION OF THE WATER RIGHT. IT IS  
 NOT INTENDED TO PROVIDE INFORMATION  
 RELATIVE TO THE LOCATION OF PROPERTY  
 OWNERSHIP BOUNDARY LINES.

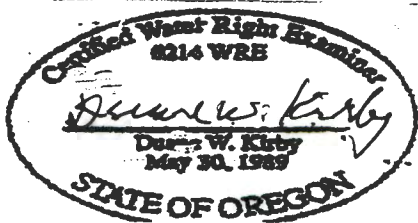

CERTIFICATE 8100 TRANSFER TO - 7.53 AC.  
 CERTIFICATE 8100 REMAINING RIGHT - 12.47AC.

VR  
 29