

CLAIM OF BENEFICIAL USE

T.15 S., R.1 W., W.M. SECTION 21

FOR: WILADENE ENGEMAN
DOMESTIC USE


LANE COUNTY, OREGON

MAP #15-01-21 TL #601 & 600

PRIORITY DATE: APRIL 2, 2007

APPLICATION No. S-86824

PERMIT No. S-54433

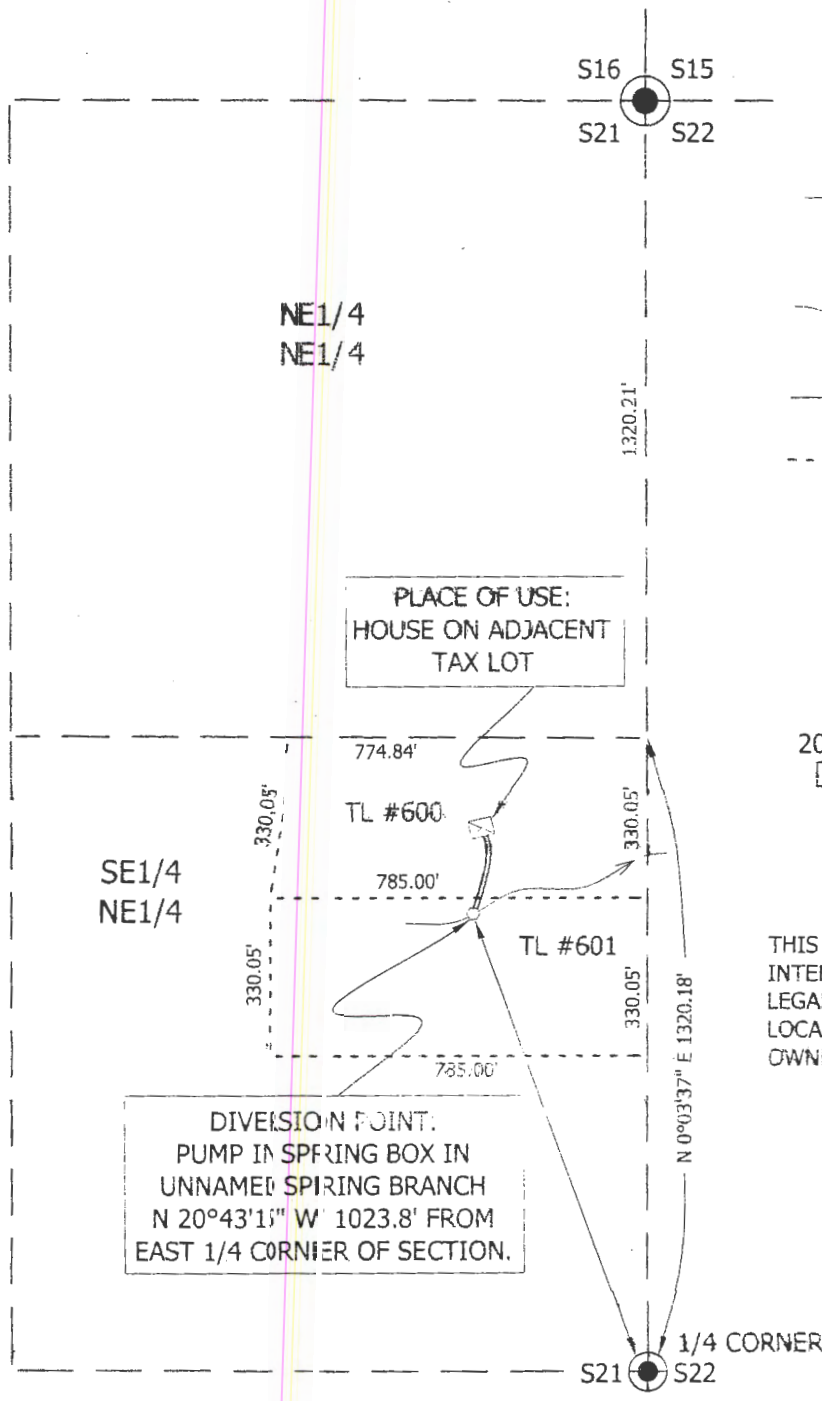

LEGEND



SECTION CORNER




SPRING, A TRIBUTARY
OF DRURY CREEK



SECTION LINE




PROPERTY LINE

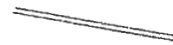

WATER PIPELINE
1 1/2" PVC PIPE

SCALE: 1 INCH = 400 FEET

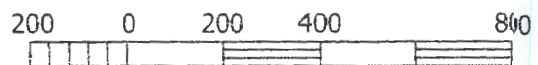

BEARINGS BASED ON CSF #32263

THIS MAP IS NOT
INTENDED TO PROVIDE
LEGAL DIMENSIONS OR
LOCATION OF PROPERTY
OWNERSHIP LINES.


SURVEYED 10-12-2016 BY:

DONN ROWE LLC

(541) 953-7778

90946 SUNDERMAN ROAD
SPRINGFIELD, OR 97478

DIVISION POINT:
PUMP IN SPRING BOX IN
UNNAMED SPRING BRANCH
N 20°43'11" W 1023.8' FROM
EAST 1/4 CORNER OF SECTION.

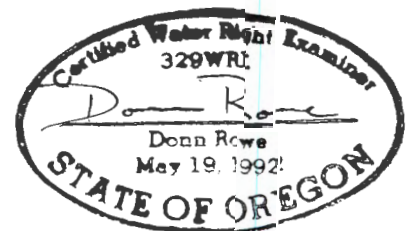

RENEWAL DATE: 12-31-2016