


CLAIM OF BENEFICIAL USE MAP
 APPLICATION R-86846 - PERMIT 14461
 GOVT. LOT 7, SECTION 31, T.40S., R.2E., W.M.
 JACKSON COUNTY, OREGON
 FOR
 BENJAMIN STOTT
 155 STRAWBERRY LANE
 ASHLAND, OR 97520

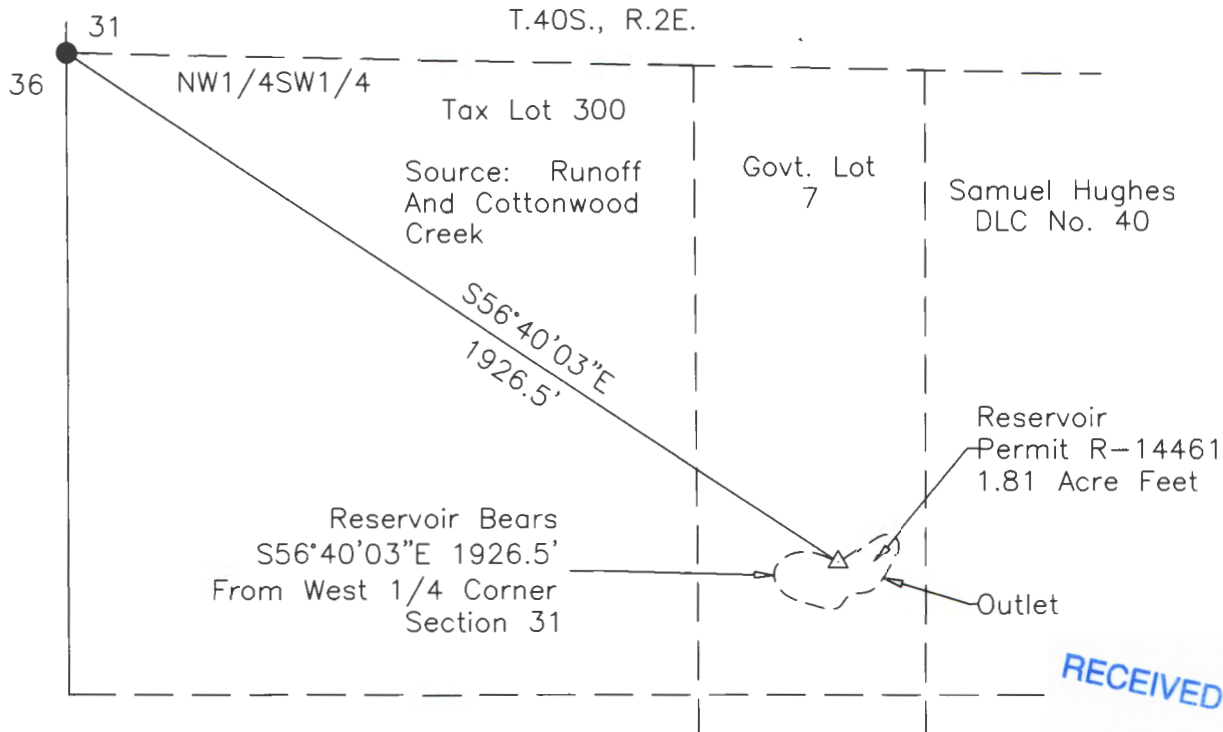

Scale: 1"=400'

Date: October 1, 2016

LEGEND

- Found BLM Corner
- △ Denotes Center Reservoir--
North Edge
- Denotes High Water
Line Reservoir


This map was prepared for the purpose of identifying the location of a water right only and is not intended to provide legal dimensions or location of property ownership.

Project: 16-35 STOTT

RECEIVED BY OWRD

OCT 07 2016

SALEM, OR

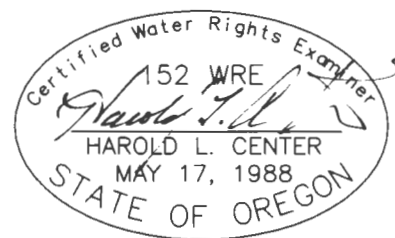

Renews: 12/31/17

HAROLD L. CENTER
 2604 David Lane
 Medford, OR. 97504
 Phone 541-535-6108
 Oregon Certificate No. 152