


RECEIVED
DEC 13 2019
OWRD

T. 22S, R. 21E, W.M.

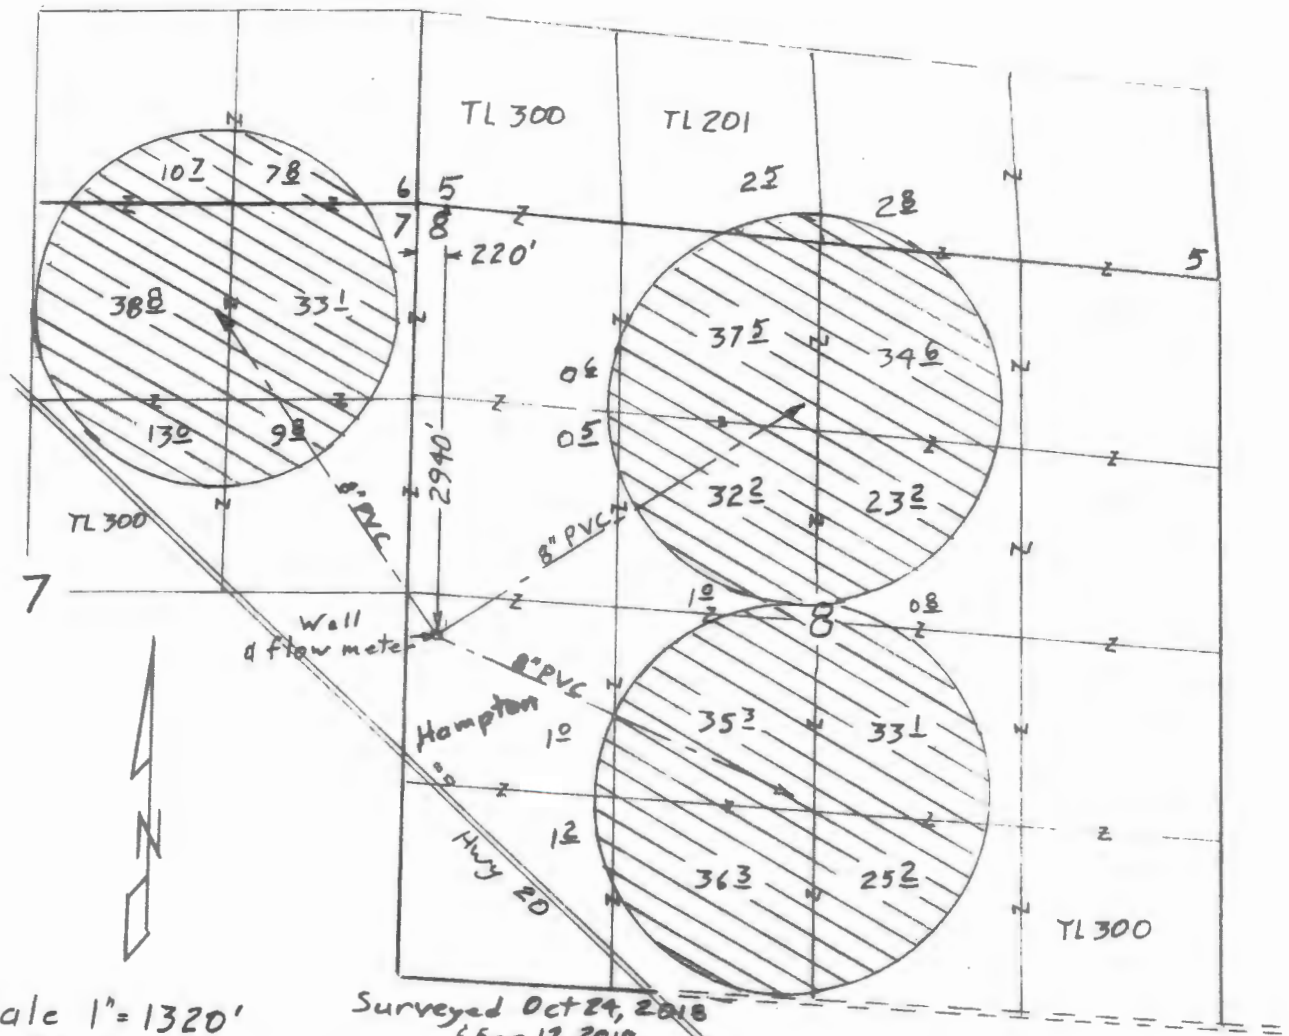


Scale 1" = 1320'
(4" = 1 mile)

Surveyed Oct 24, 2018
5 Sep 12, 2019

⊗ Irrigation 381⁰ acres

App G-12997
Per G-12646

Claim of Beneficial Use Map for Stephen & Cloncy Roth

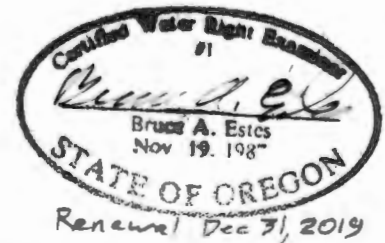

RECEIVED
JAN 16 2020
OWRD

This map is for the purpose of locating a water right only and has no intent to provide legal dimensions or the location of property lines.

ESTES SURVEYS, LLC
 PO Box 17519 Salem, OR 97305-7519 (503) 365-7333
 60382 Arnold Rd Bend, OR 97702 (541) 382-7391