

APR 27, 2020

T.2S. R.1W. Section 35, W.M.


OWRD

35

SW Boones Ferry Rd.

SW Norwood Rd.

TL 2S 1 35D 106

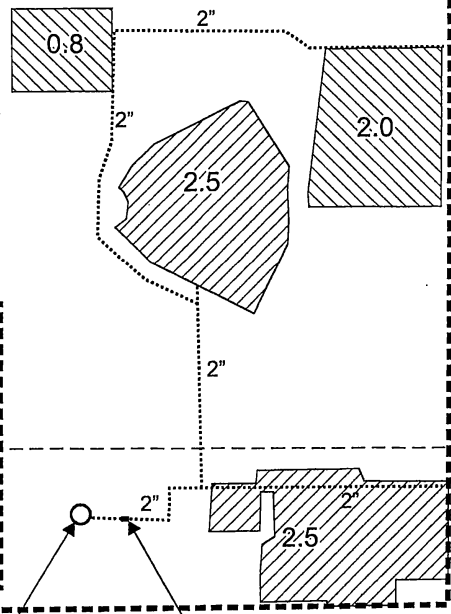

Interstate 5

Well 1 (WASH 52021)

Meter Location

Well 1 (WASH 52021) is located 1,170 feet north and 2,075 feet west from the SE corner, Section. 35.


SW Greenhill Ln.

Township 2S	35	36
Township 3S	2	1

- Area (2.8 acres) irrigated from Certificate 30844
- Area (5.0 acres) irrigated from Certificate 64616

- Tax lot boundary
- Water main line

Scale: 1" = 400'

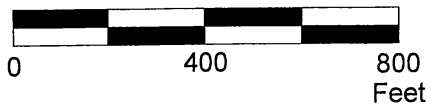

This map was prepared for the purpose of identifying the location of a water right only and is not intended to provide legal dimensions or location of property ownership lines.



Claim of Beneficial Use Map T-10135

Pacific Hydro-Geology Inc.

01/2020
Rev 04?2020

Horizon Community Church
T.2S. R.1W. Section 35, W.M.

GraceT-10135COBUMap.cdr