

CLAIM OF BENEFICIAL USE SURVEY

APPLICATION G-15611 & PERMIT G-15232

T38S R1E SECTION 17 W.M. JACKSON COUNTY, OREGON

Taxlot 38-1E-17-700

— Quarter-Quarter (JC Assessor)
— JC Assessor Taxlots
— W — Buried Water Line



Place of Use

- Structure
- ⊙ Point of Appropriation (JACK??)
- ⊞ Water Infrastructure - as noted

Note 1 1.5 HP Booster Pump EL: 2130 FT.

WATER USES LOCATED IN THE SWSW SEC. 17 (Taxlot 700)

12.19 Irrigated Acres
3 Domestic Households
1 Exempt Domestic Household
1 Exempt Commercial Use for Kennel
Exempt Stock Watering

Scale: 1 inch = 400 feet

Survey For:


Kathy Murphy
2868 N. Valley View Rd.
Ashland, OR 97520

Survey By:

Scott Fein Water Rights
Scott Fein, CWRE
600 Tyler Creek Rd.
Ashland, OR 97520
541-842-0795
sfeinsurveyor@gmail.com

Field Survey: September 5, 2015

For Water Right Purposes Only. Not For Property Boundary Location.

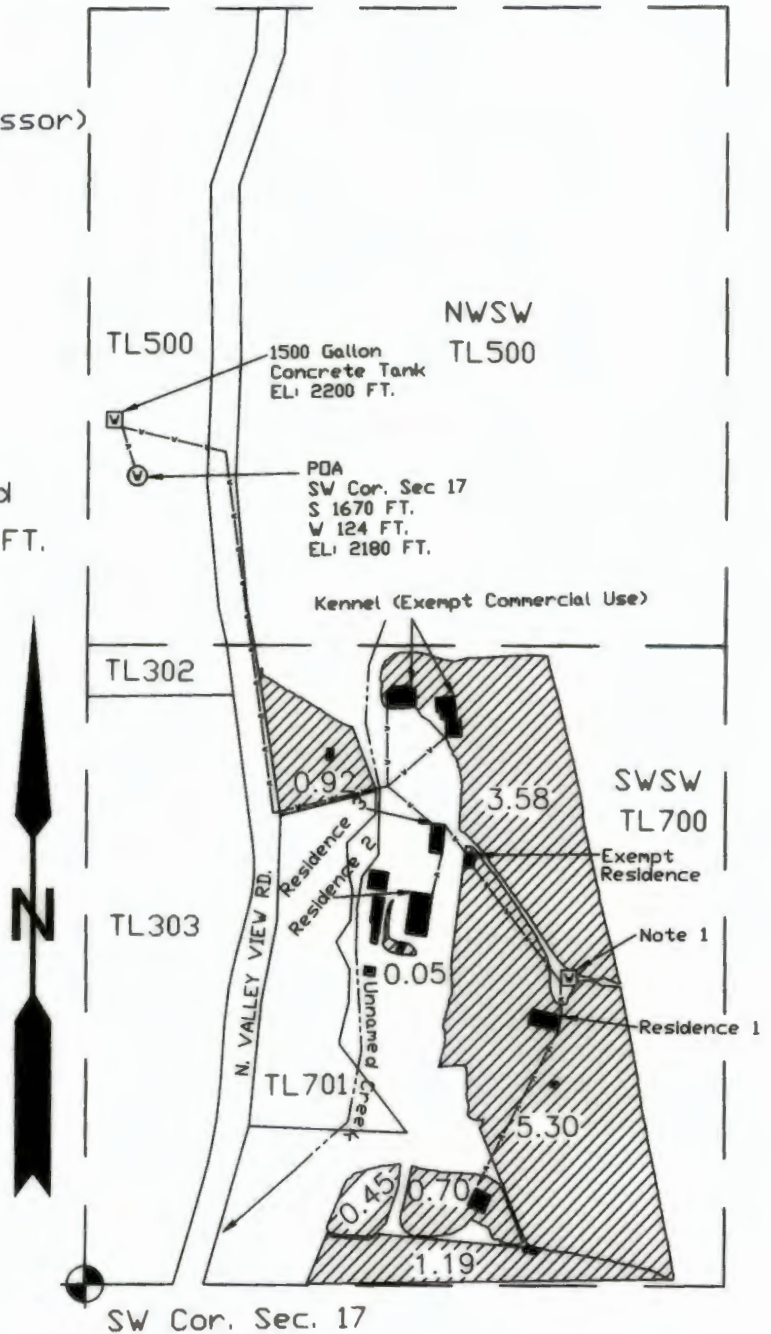

RECEIVED BY OWRD

SEP 28 2017

SALEM, OR



RECEIVED BY OWRD

OCT 19 2017

SALEM, OR