


T.35S.R.2 W.W.M.

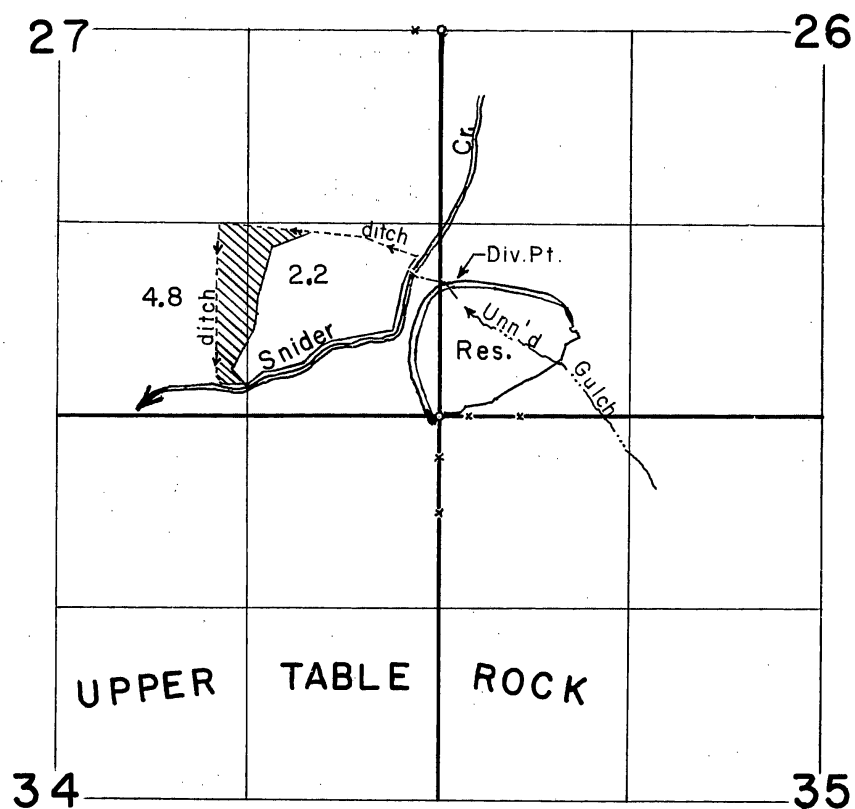

FINAL PROOF SURVEY UNDER

Application No. 34638 Permit No. 27208
IN NAME OF

Werner J. & Patricia A. Donat

Surveyed June 14 1966, by D.C. Hendrix