


Township 7 South, Range 1 West, W. M.

Portions of Sections 4 & 5

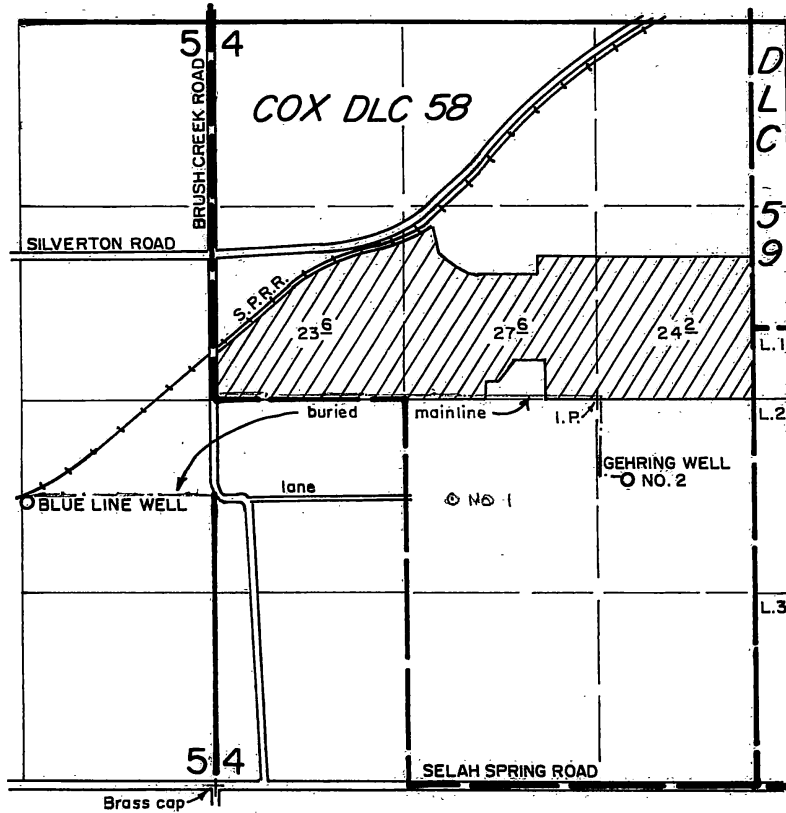

WELLS LOCATED: BLUE LINE, 1950' N. & 1290' W. FROM SE COR. SEC. 5.
GEHRING NO. 2, 520' S. & 200' E. FROM CEN. SEC. 4.

FINAL PROOF SURVEY
under
Appl. No. G-13261, Per. No. G-12146
in name of


BLUE LINE FARMS

Oct. 7, 1998

RECEIVED

OCT 13 1998

WATER RESOURCES DEPT
Salem, OREGON

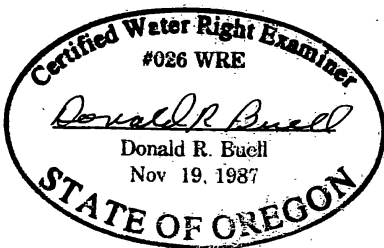

THIS MAP WAS PREPARED FOR THE PURPOSE OF IDENTIFYING THE LOCATION OF A WATER RIGHT ONLY AND IS NOT INTENDED TO PROVIDE LEGAL DIMENSIONS OR LOCATION OF PROPERTY OWNERSHIP LINES.