



COBU MAP #122866

LAYOUT: T-12724 DATE: 12/20/2019 10:02:35 PM PLOTTED BY: madhys DATE: Thursday, April 16, 2020 15:02:35 PM

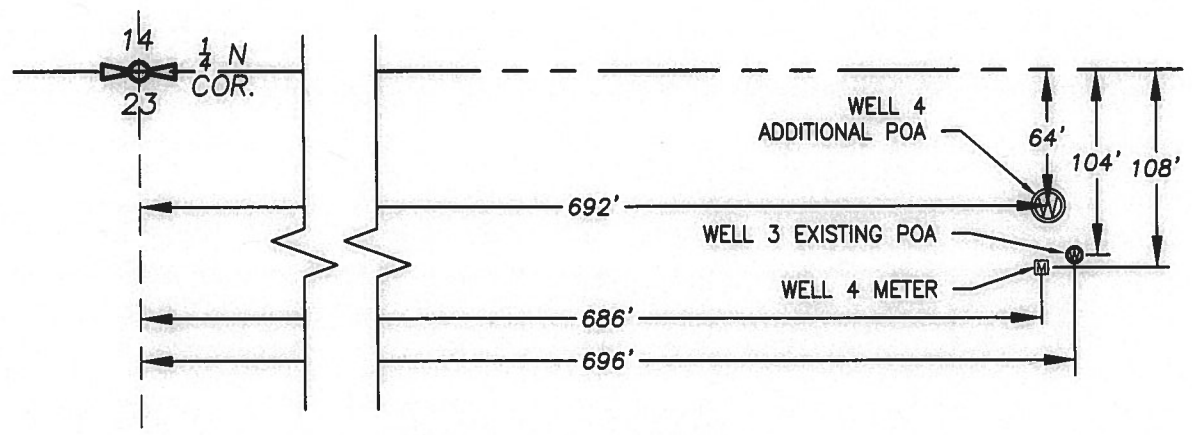

WELLS 3 & 4 DETAIL
N.T.S.

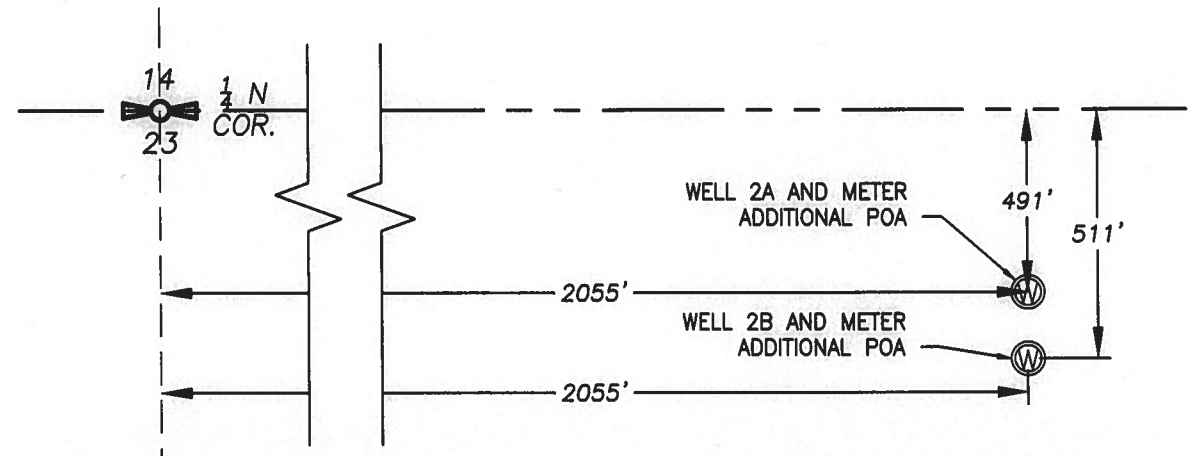


WELLS 2A & 2B DETAIL
N.T.S.



LEGEND

- PLACE OF USE / SERVICE AREA
- ADDITIONAL WELL/POA
- EXISTING WELL/POA


NOTE: THIS MAP WAS PREPARED FOR THE PURPOSE OF IDENTIFYING THE LOCATION OF WATER RIGHTS. THIS MAP IS NOT INTENDED TO PROVIDE DIMENSIONS OR THE LOCATION OF PROPERTY OWNERSHIP LINES.

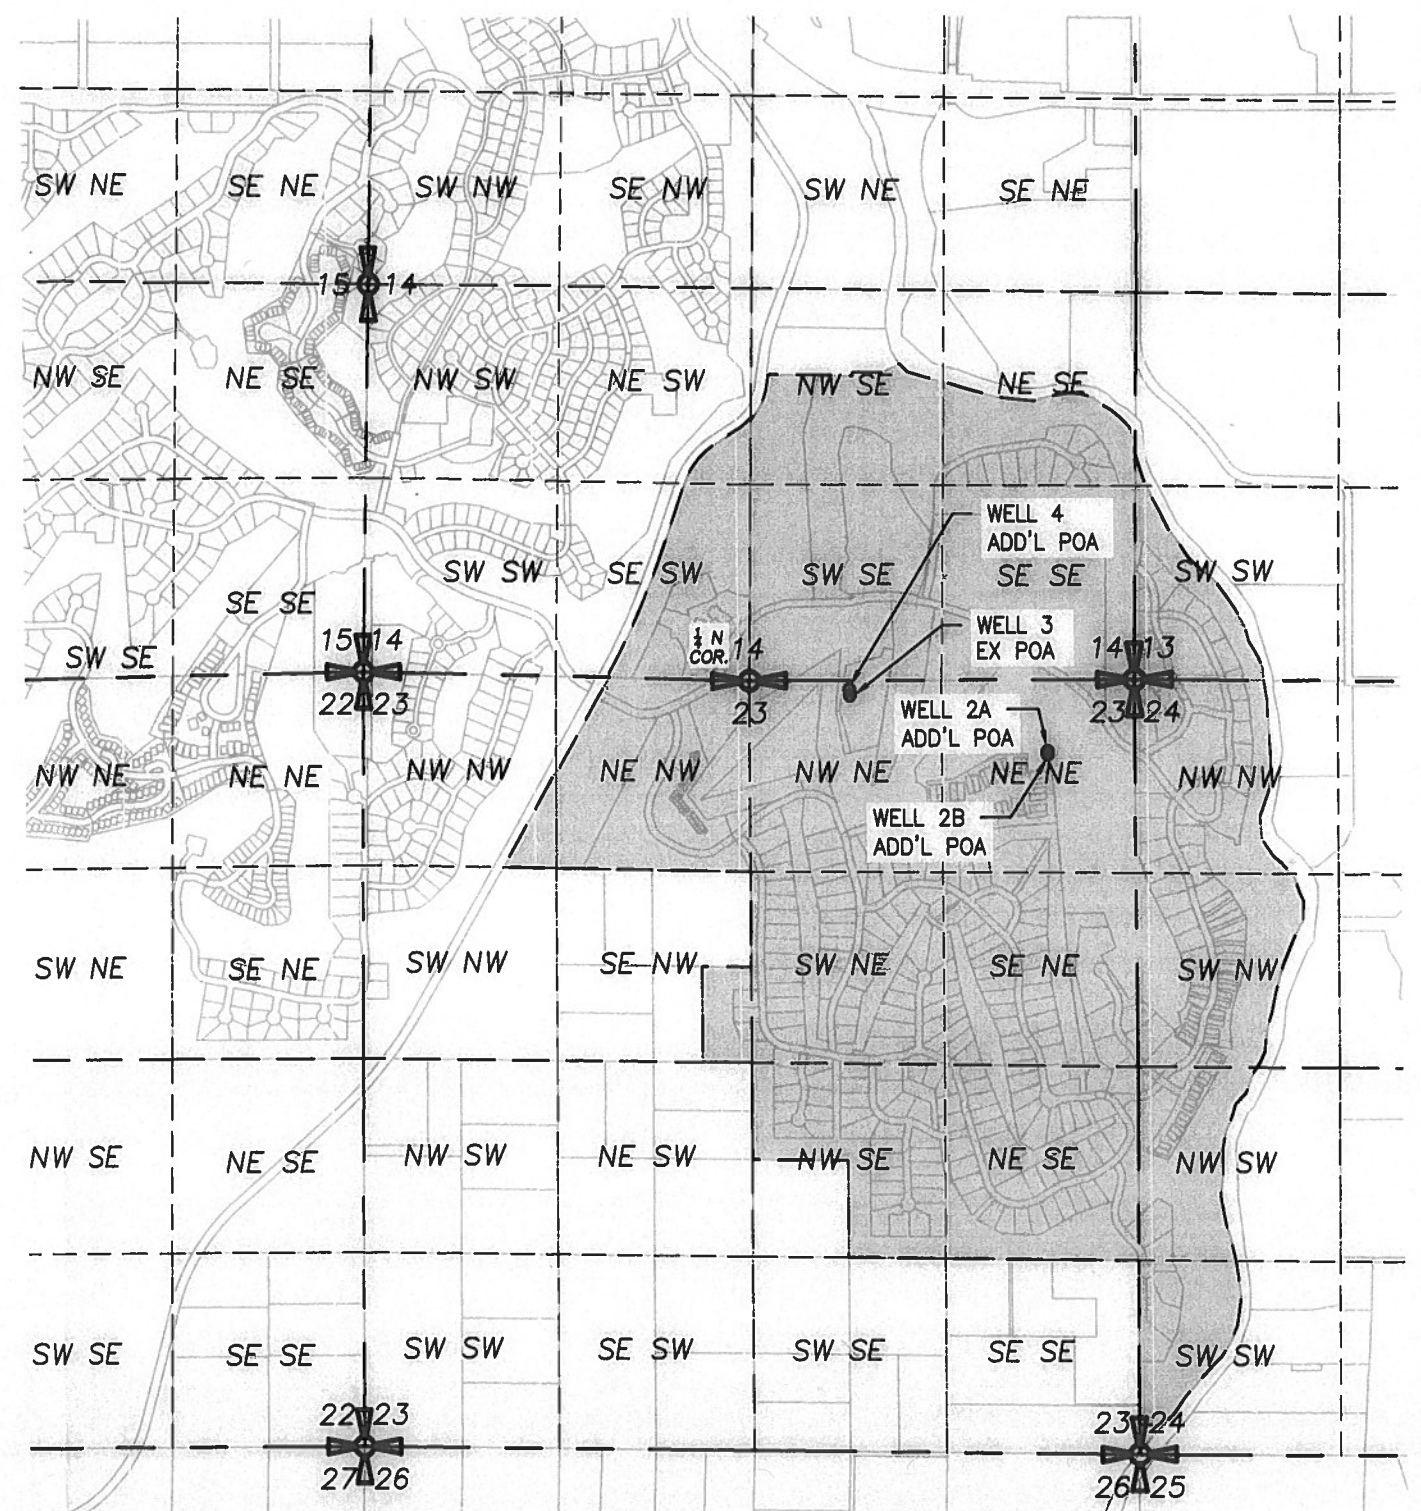

NOTE: SEE DETAILS FOR WELL LOCATIONS T.15S, R.12E



CLAIM OF BENEFICIAL USE MAP FOR TRANSFER T-12724

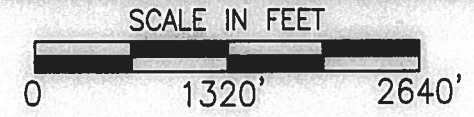

RECEIVED

APR 20 2020

OWRD

REVISIONS	DATE	BY

Parametrix
ENGINEERING PLANNING ENVIRONMENTAL SCIENCES
595 SW BLUFF DRIVE, SUITE B | BEND, OR 97702
P 541.338.7710
WWW.PARAMETRIX.COM

DATE: 12/20/2019
DRAWN: [Signature]
APPROVED: [Signature]

PROJECT NAME
EAGLE CREST MASTER ASSOCIATION WATER RIGHTS
OREGON

CLAIM OF BENEFICIAL USE MAP FOR TRANSFER T-12724