


POLK COUNTY

SCALE 1" = 500 FEET.

Scale 1" = 500'  
See Map 6.4.16

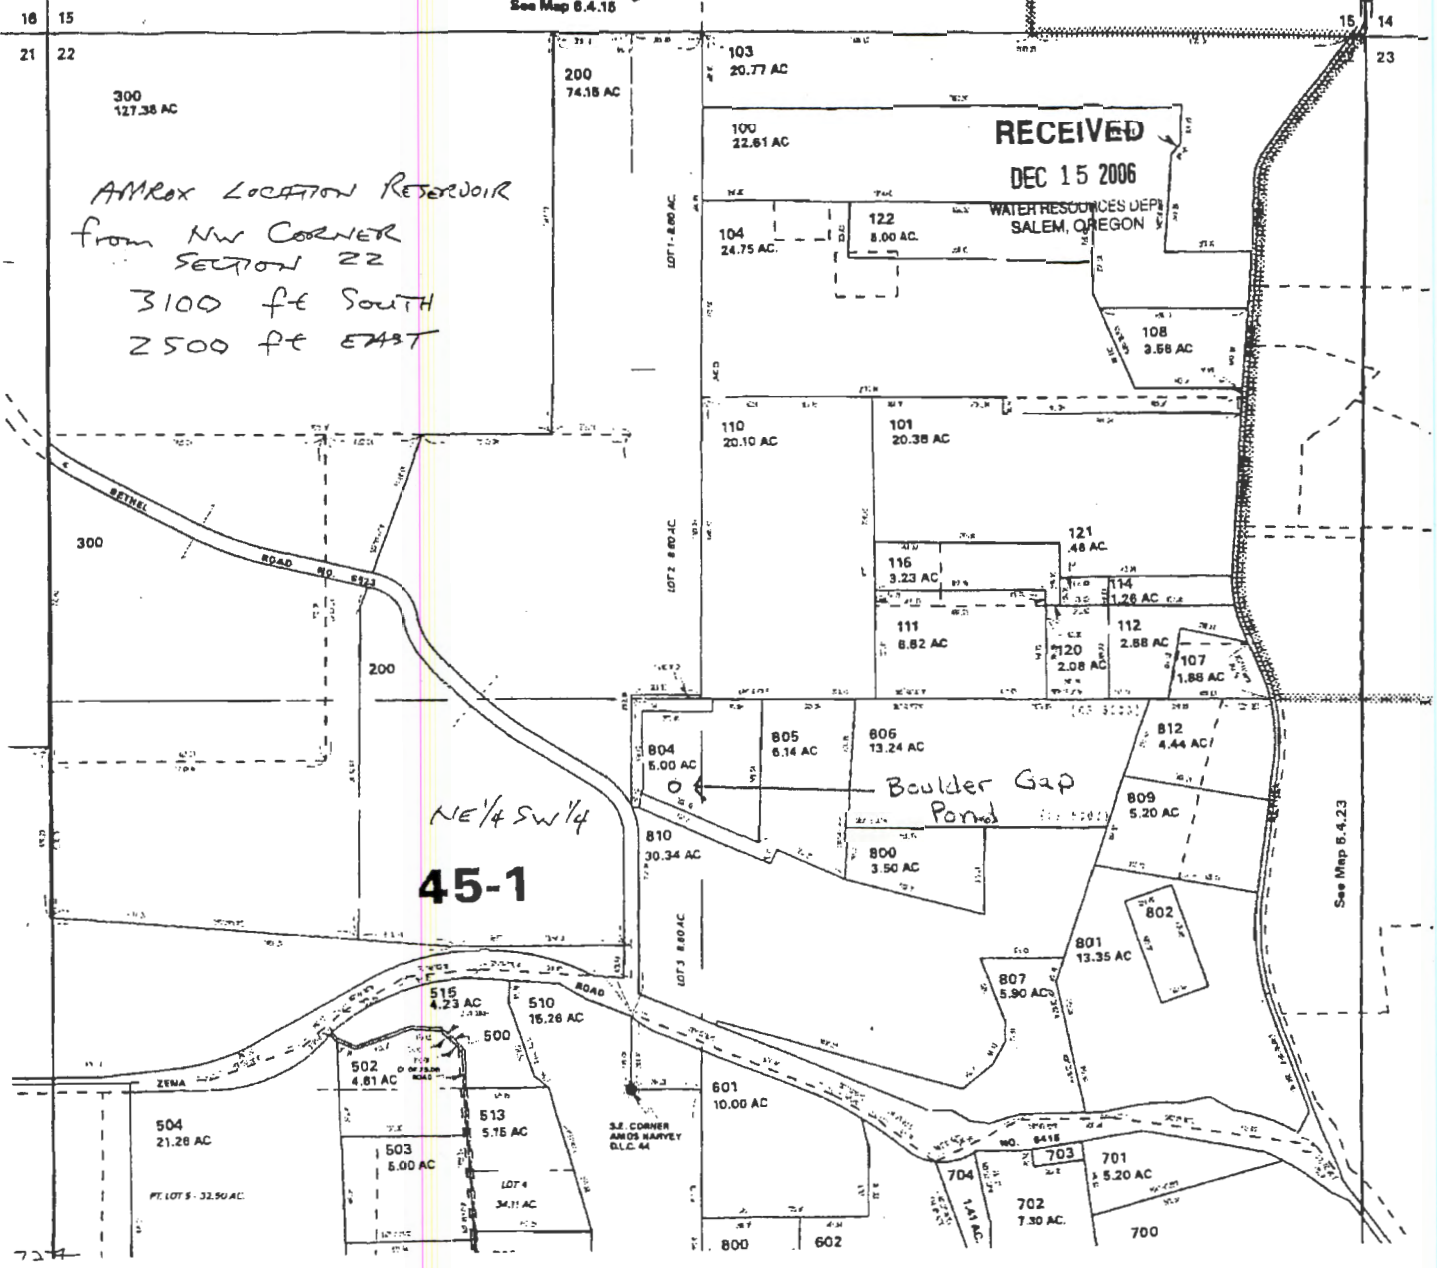

RECEIVED  
DEC 15 2006

WATER RESOURCES DEPT  
SALEM, OREGON

45-1

Boulder Gap Pond

RECEIVED

APR 0 2018

OWRD