

RECEIVED BY OWRD

SEP 14 2015

SALEM, OR


THE POINT OF DIVERSION IS LOCATED 1754 FEET SOUTH AND 1197 FEET EAST FROM THE SOUTHEAST CORNER OF DLC 59, BEING WITHIN THE NW 1/4 SE 1/4 OF SECTION 34, TOWNSHIP 30 SOUTH, RANGE 5 WEST, W.M.

LEGEND

- TOWNSHIP / RANGE
- URBAN GROWTH BOUNDARY
- CITY LIMITS

THE PURPOSE OF THIS MAP IS TO IDENTIFY THE LOCATION OF THE WATER RIGHT. THIS MAP IS NOT INTENDED TO PROVIDE LEGAL DIMENSIONS OR LOCATIONS OF PROPERTY OWNERSHIP LINES.

PLAN SCALE

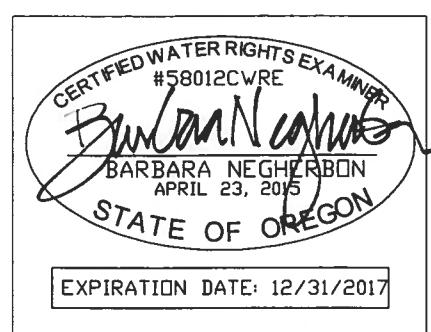

SEC.32 T.30 R.5W. W.M.

SEC.33 T.30 R.5W. W.M.

SEC. 34 T. 30 R. 5W. W.M.

СОВУ МАР 940

PROJECT NO.: 18004
E: AUG, 2015

City of Canyonville

FIGURE NO.

ORI