


FINAL PROOF MAP

TO ADD PLACE OF USE &
POINT OF APPROPRIATION
FOR APPLICATION G-17705


TAX LOT: 1700 IN SECTION 10,
TOWNSHIP 23 SOUTH, RANGE 32 EAST, W.M.

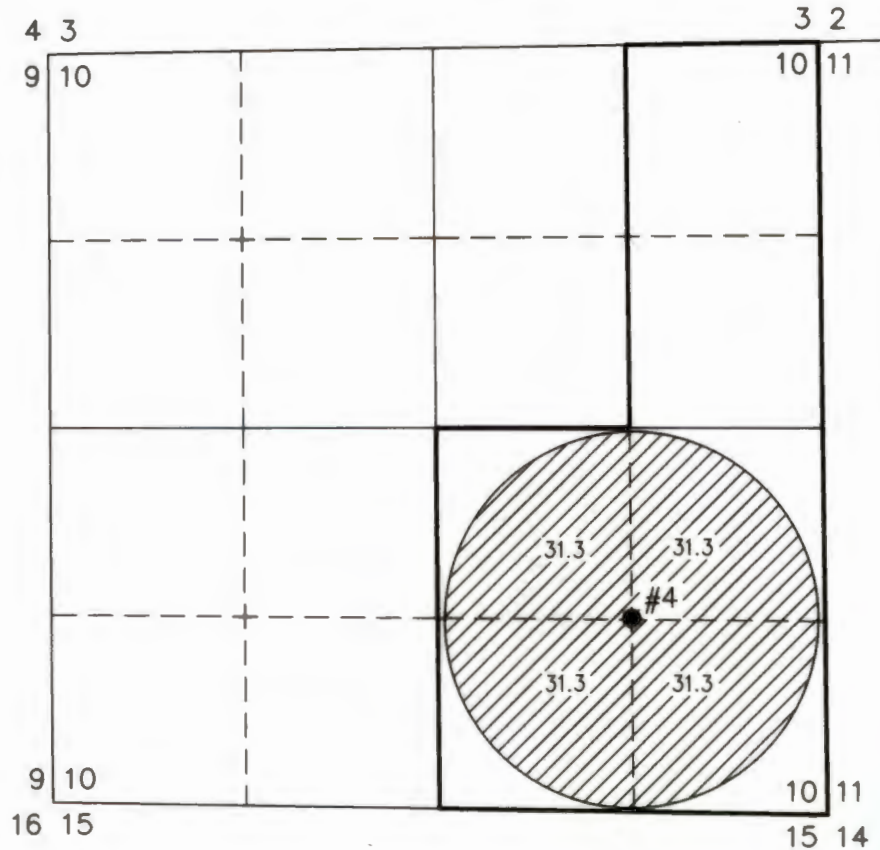

RECEIVED

JUL 25 2018

OWRD

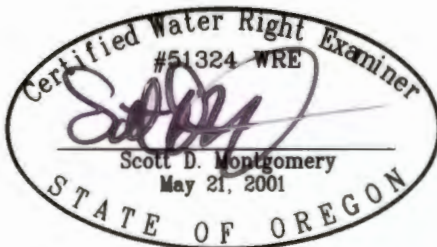

RENEWAL DATE: 12/31/2018

#4 (HARN 52620)

LOCATED IN THE NW 1/4 SE 1/4 SECTION 10, T23S
R32E, W.M. AND 1323 FEET NORTH AND 1328 FEET
WEST FROM THE SE CORNER OF SECTION 10.
FLOW METER IS LOCATED 60 FEET SOUTH AND 60
FEET WEST OF WELL ON THE PIVOT SPRINKLER.



125.2 ACRES 'ir' RIGHTS FROM #4
PER G-17317, AS SHOWN.

THIS MAP IS FOR THE PURPOSE OF LOCATING A WATER RIGHT ONLY AND HAS NO
INTENT TO PROVIDE LEGAL DIMENSIONS OR THE LOCATION OF PROPERTY LINES.

PREPARED FOR:

OREGON DEPT. OF STATE LANDS
1645 NE FORBES ROAD, SUITE 112
BEND, OR 97701

PREPARED BY:



ALL POINTS ENGINEERING AND SURVEYING, INC.
P.O. BOX 767 TERREBONNE, OR 97760
(541) 548-5833 www.APEandS.com