
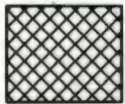


FINAL PROOF MAP

TO ADD PLACE OF USE AND
POINTS OF APPROPRIATION
FOR APPLICATION G-16381
CHAD AND CHARMARIE BRADACH

TOWNSHIP 24 SOUTH, RANGE 33 EAST, SECTIONS 8 & 17,
W.M.
TAX LOTS: 1900, 4200, & 4300 HARNEY COUNTY, OREGON

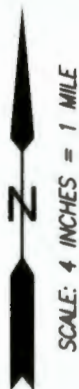


120.0 ACRES FROM PERMIT
G-17374, AS SHOWN



RENEWAL DATE: 12/31/2016

THIS MAP IS FOR THE PURPOSE OF
LOCATING A WATER RIGHT ONLY AND HAS NO
INTENT TO PROVIDE LEGAL DIMENSIONS OR
THE LOCATION OF PROPERTY LINES

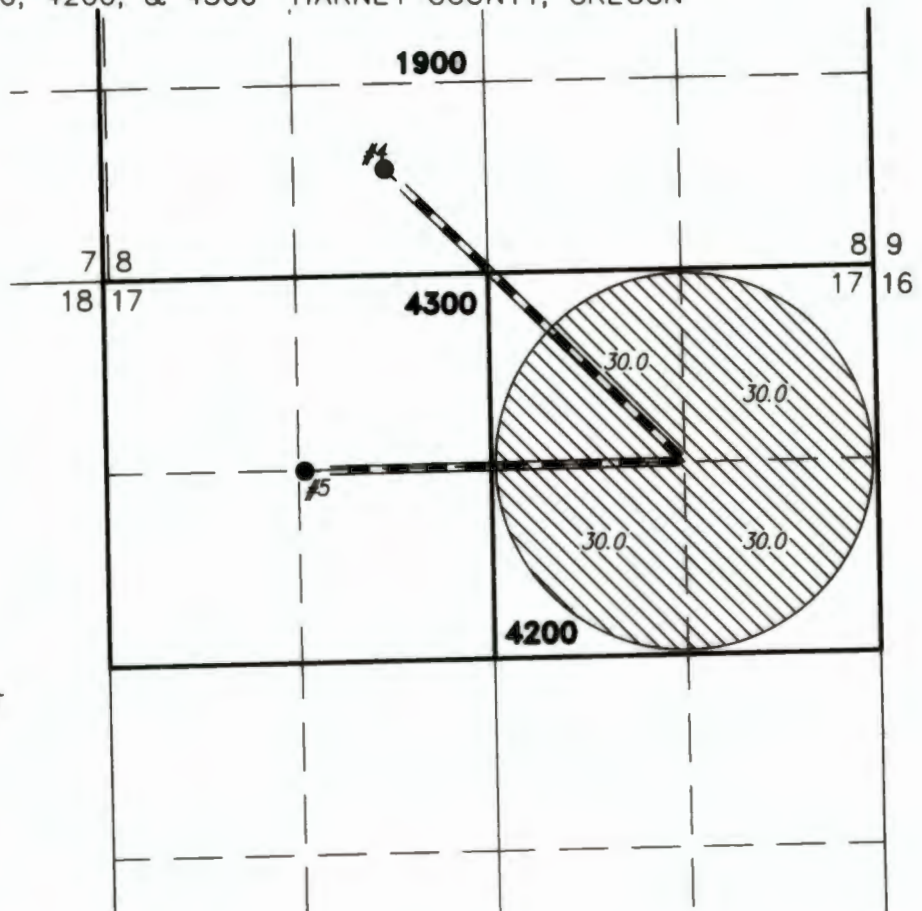

● POA 4

EXISTING WELL (HARN 982) PERMIT: G-17374
730' NORTH 1945' EAST FROM THE SW CORNER SECTION 8

METER IS LOCATED ON THE DELIVERY PIPE 6 FEET SOUTH OF
THE WELL

● POA 5

EXISTING WELL (HARN 1014) PERMIT: G-17374
1325' SOUTH 1365' EAST FROM THE NW CORNER SECTION 17

METER IS LOCATED ON THE DELIVERY PIPE 24.5 FEET SOUTH
OF THE WELL

PREPARED FOR:

CHAD AND CHARMARIE BRADACH
65268 HWY 205
BURNS, OR 97720



PREPARED BY:



ALL POINTS ENGINEERING AND SURVEYING, INC.
P.O. BOX 767
(541) 548-5833
TERREBONNE, OR 97760
www.APEandS.com

**T24S, R33E
SECTION 07 AND 08**


HARNEY COUNTY, OREGON

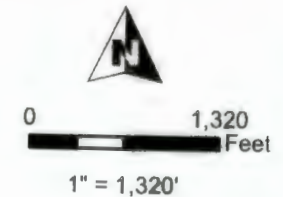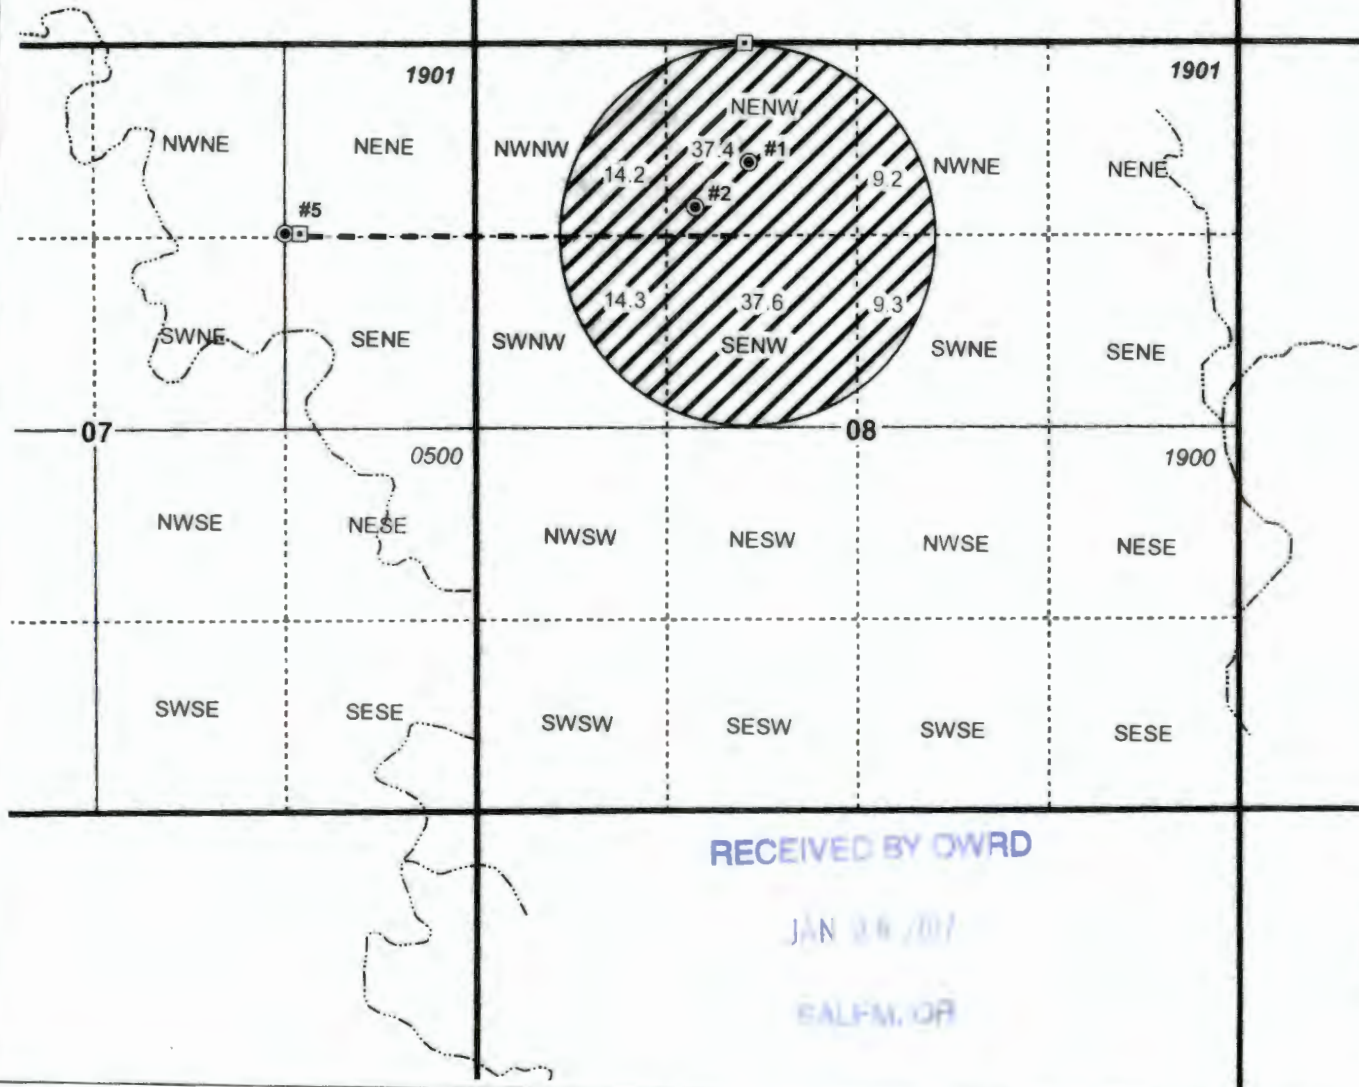

- POU Irrigation
- Section
- Quarter Quarter Section
- Taxlot
- Well
- Meter
- Stream
- Buried Pipeline

WELL LOCATIONS:

WELL #1: 780' S, 1,890' E OF NW CORNER SEC 8
 WELL #2: 1,090' S, 1,520' E OF NW CORNER SEC 8
 WELL #5: 1,320' S, 1,290' W OF NW CORNER SEC 8

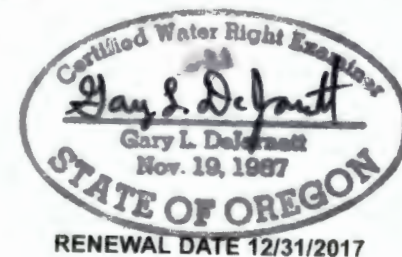

CLAIM OF BENEFICIAL USE
 Cameron & Rachel Koehn

AP G-16381

PERMIT G-17374

NOTE: THIS MAP IS NOT INTENDED TO
 PROVIDE LEGAL DIMENSIONS OR LOCATIONS
 OF PROPERTY OWNERSHIP LINES.

PROJECT #15103

SEPTEMBER 26, 2016

WATER RIGHT SERVICES, LLC

PO BOX 1830, BEND, OR 97709

CCB# 197121 www.oregonwater.us

541-389-2837 JOHNSHORT@USA.COM