

FINAL PROOF MAP

TO ADD PLACE OF USE AND POINTS OF APPROPRIATION
FOR APPLICATION G-16964


LINDA MALLERY-MCLEAN

TOWNSHIP 22 SOUTH, RANGE 32 EAST, SECTION 28, W.M.
TAX LOT: 1900

RECEIVED

SEP 09 2019

OWRD

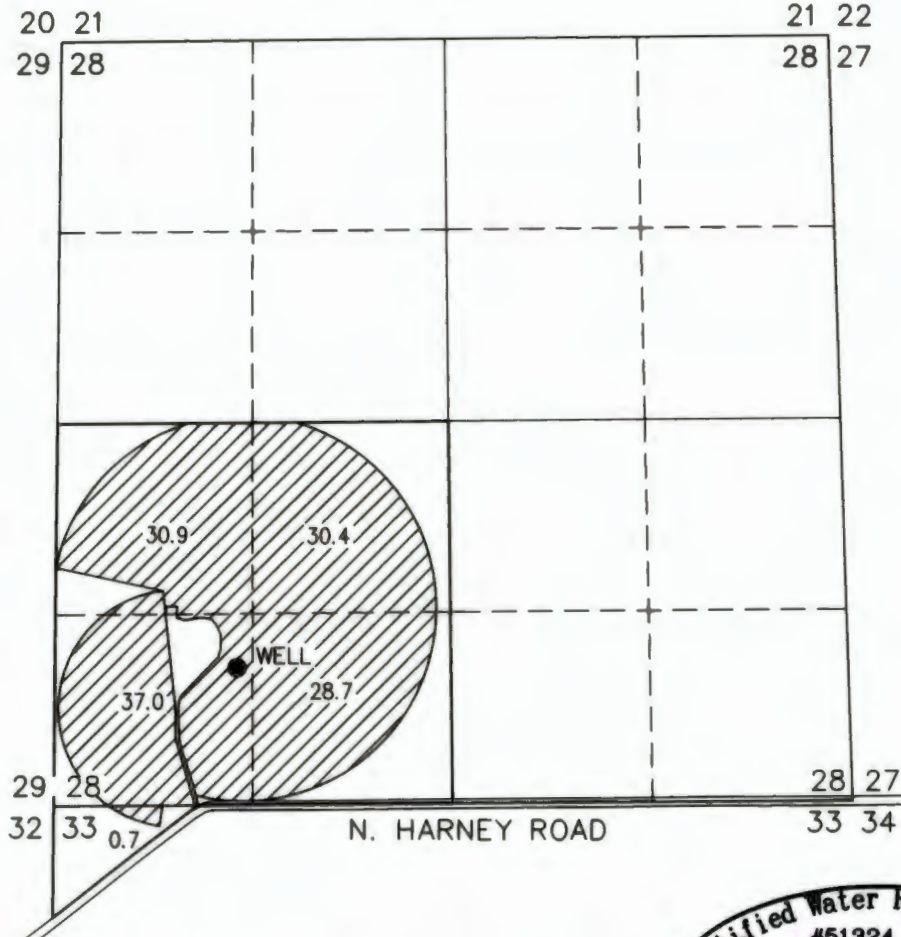


● WELL (HARN 51405)

LOCATED IN THE SW 1/4 OF THE SW 1/4
OF SECTION 28 & 907 FEET NORTH &
1307 FEET EAST FROM THE SW CORNER
OF SECTION 28, TOWNSHIP 22 SOUTH,
RANGE 32 EAST, W.M., HARNEY COUNTY,
OREGON. FLOWMETER IS 7 FEET NE FROM
WELL.



127.7 ACRES PRIMARY
IRRIGATION FROM APP.
G-16964, AS SHOWN

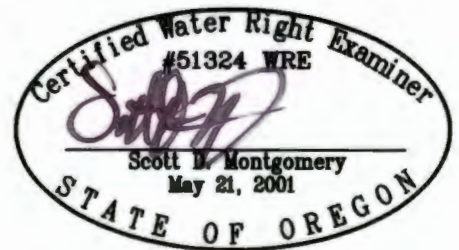

RENEWAL DATE: 12/31/2020

THIS MAP IS FOR THE PURPOSE OF DESIGNING AN
IRRIGATION SYSTEM PLAN AND HAS NO INTENT TO PROVIDE
LEGAL DIMENSIONS OR THE LOCATION OF PROPERTY LINES

PREPARED FOR:

LINDA MALLERY-MCLEAN
34775 N. HARNEY ROAD
BURNS, OR 97720

PREPARED BY:



ALL POINTS ENGINEERING AND SURVEYING, INC.
P.O. BOX 767 (CRR) TERREBONNE, OR 97760
(541) 548-5833
www.APEandS.com