


T. 23 S., R. 32 E., W. M.
HARNEY CO., ORE.

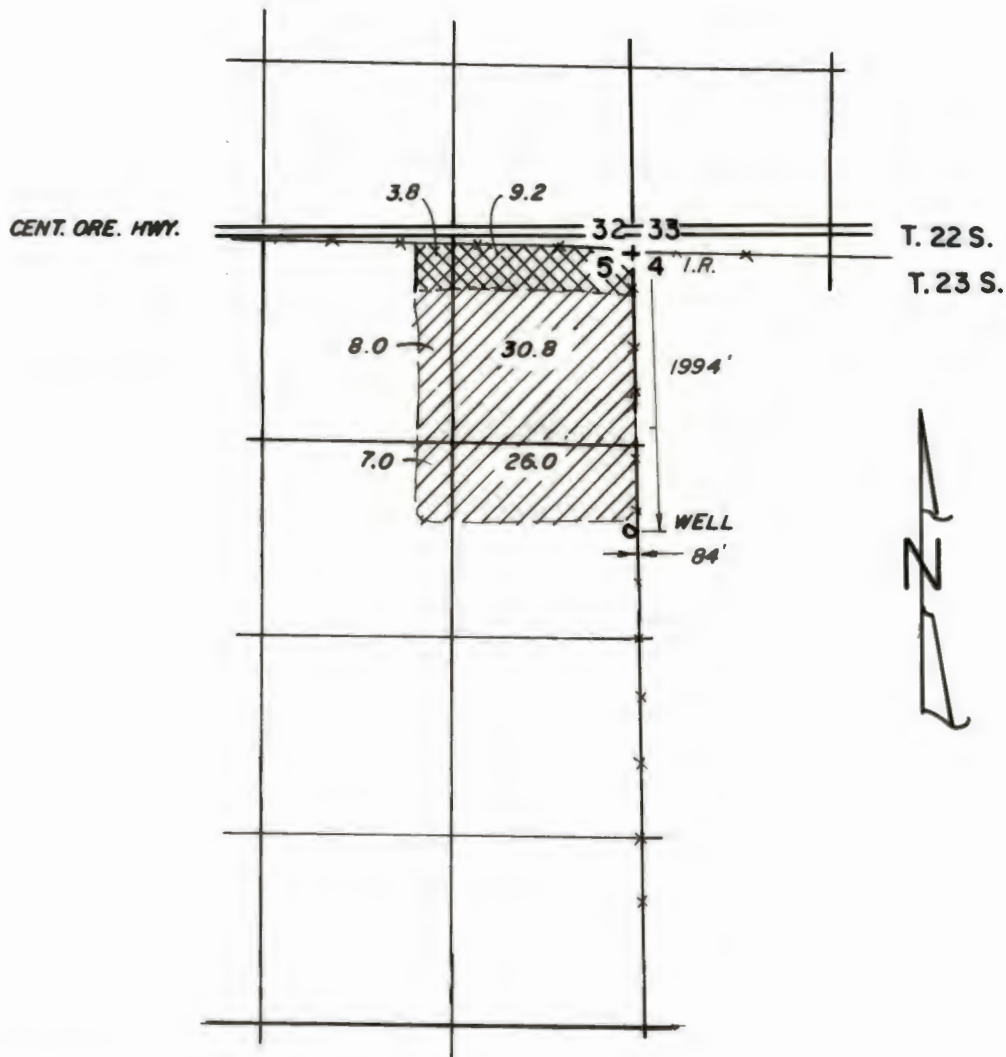

NOTES

**I. PERMIT IS FOR SUPPLEMENTAL IRRIGATION
 TO PERMIT 12960.**



**EXCESS ACREAGE NOT INCLUDED IN PERMIT
 NO. S 12960 & G-10816**

THE PURPOSE OF THIS MAP IS TO
 IDENTIFY THE LOCATION OF THE
 WATER RIGHT. IT IS NOT INTENDED
 TO PROVIDE INFORMATION RELATIVE
 TO THE LOCATION OF PROPERTY
 OWNERSHIP.

REV. 2/8/93 C.F.P.

	IN THE NAME OF: DAVID REED		
	FINAL PROOF MAP		
	APPL. NO. G-11723 PERMIT NO. G-10816		
	Scale: 1" = 1320'	Date: OCT. 1, 1992	Job: 1335
	Dsn: -	M. A. PALMER & SONS, INC. ENGINEERING & SURVEYING 254 N. Alder - Box 61 Burns, Oregon 97720	Sht. No.
Dm: CORK	of 1		
Ckd: -			