


CLAIM OF BENEFICIAL USE MAP

LOCATED IN THE NE 1/4 OF THE NW 1/4 OF SECTION 21, TOWNSHIP 23 SOUTH., RANGE 12 WEST., W.M. COOS COUNTY, OREGON
TAX MAP 23S 12W SEC21 TAX LOT 1600
APPLICATION S-87979, PERMIT S-54903

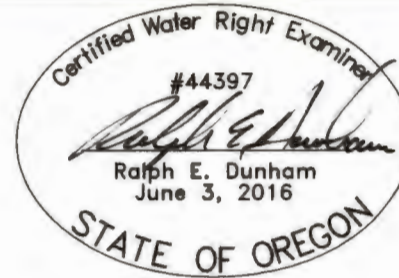

EXPIRES 12/31/17


TAX LOT 600
34.48 AC.

SECTION 16

SECTION 21

SECTION 16
SECTION 21

1/4 SECTION LINE
POB
1/4 CORNER

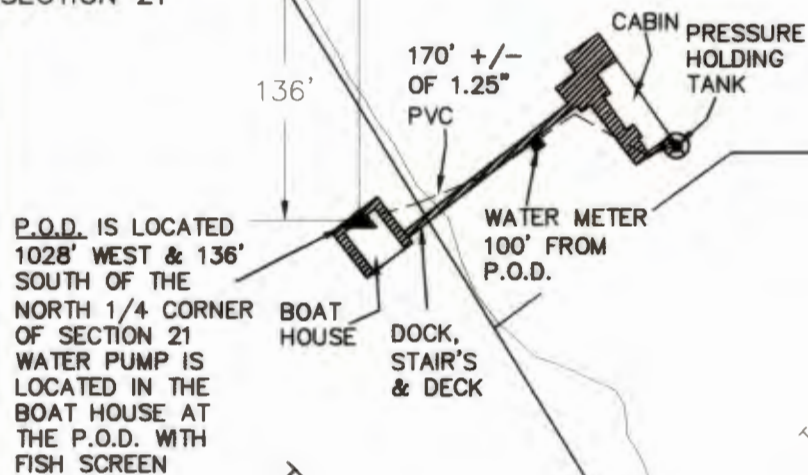

TAX LOT 1600
0.89 AC.

TAX LOT 1601
1.20 AC.

TAX LOT 1500
1.87 AC.

RECEIVED BY OWRD

AUG 14 2017

SALEM, OR

TEN MILE LAKE

SCHOOL LAND BAY



LEGEND

--- 1.25" PVC WATER LINE

◆ SENSUS WATER METER

⊗ WELLMATE PRESSURE HOLDING TANK

▲ POINT OF DIVERSION, WATER PUMP WITH FISH SCREEN

"THIS MAP IS NOT INTENDED TO GIVE LEGAL DIMENSIONS OR LOCATIONS OF PROPERTY OWNERSHIP LINES"



705 S. 4TH ST.
P.O. BOX 118
COOS BAY, OREGON 97420

PHONE: (541) 267-2872
FAX: (541) 267-0588
www.stuntzner.com

Engineering - Land Surveying - Forestry - Land Planning - Water Rights

JOB #: 117-3-055

DATE: July 18, 2017

DRAWN BY: JDT

CHECKED BY: JAK

PREPARED FOR:

Alan and Jan Rutherford
24171 Old River Rd
Junction City, Or. 97448

FILE NAME: Allen Rutherford.dwg

SHEET 1 OF 1