



FINAL PROOF MAP
 UNDER S-85852, P-54090
 Sec 2, T.34S., R.1W., W.M.

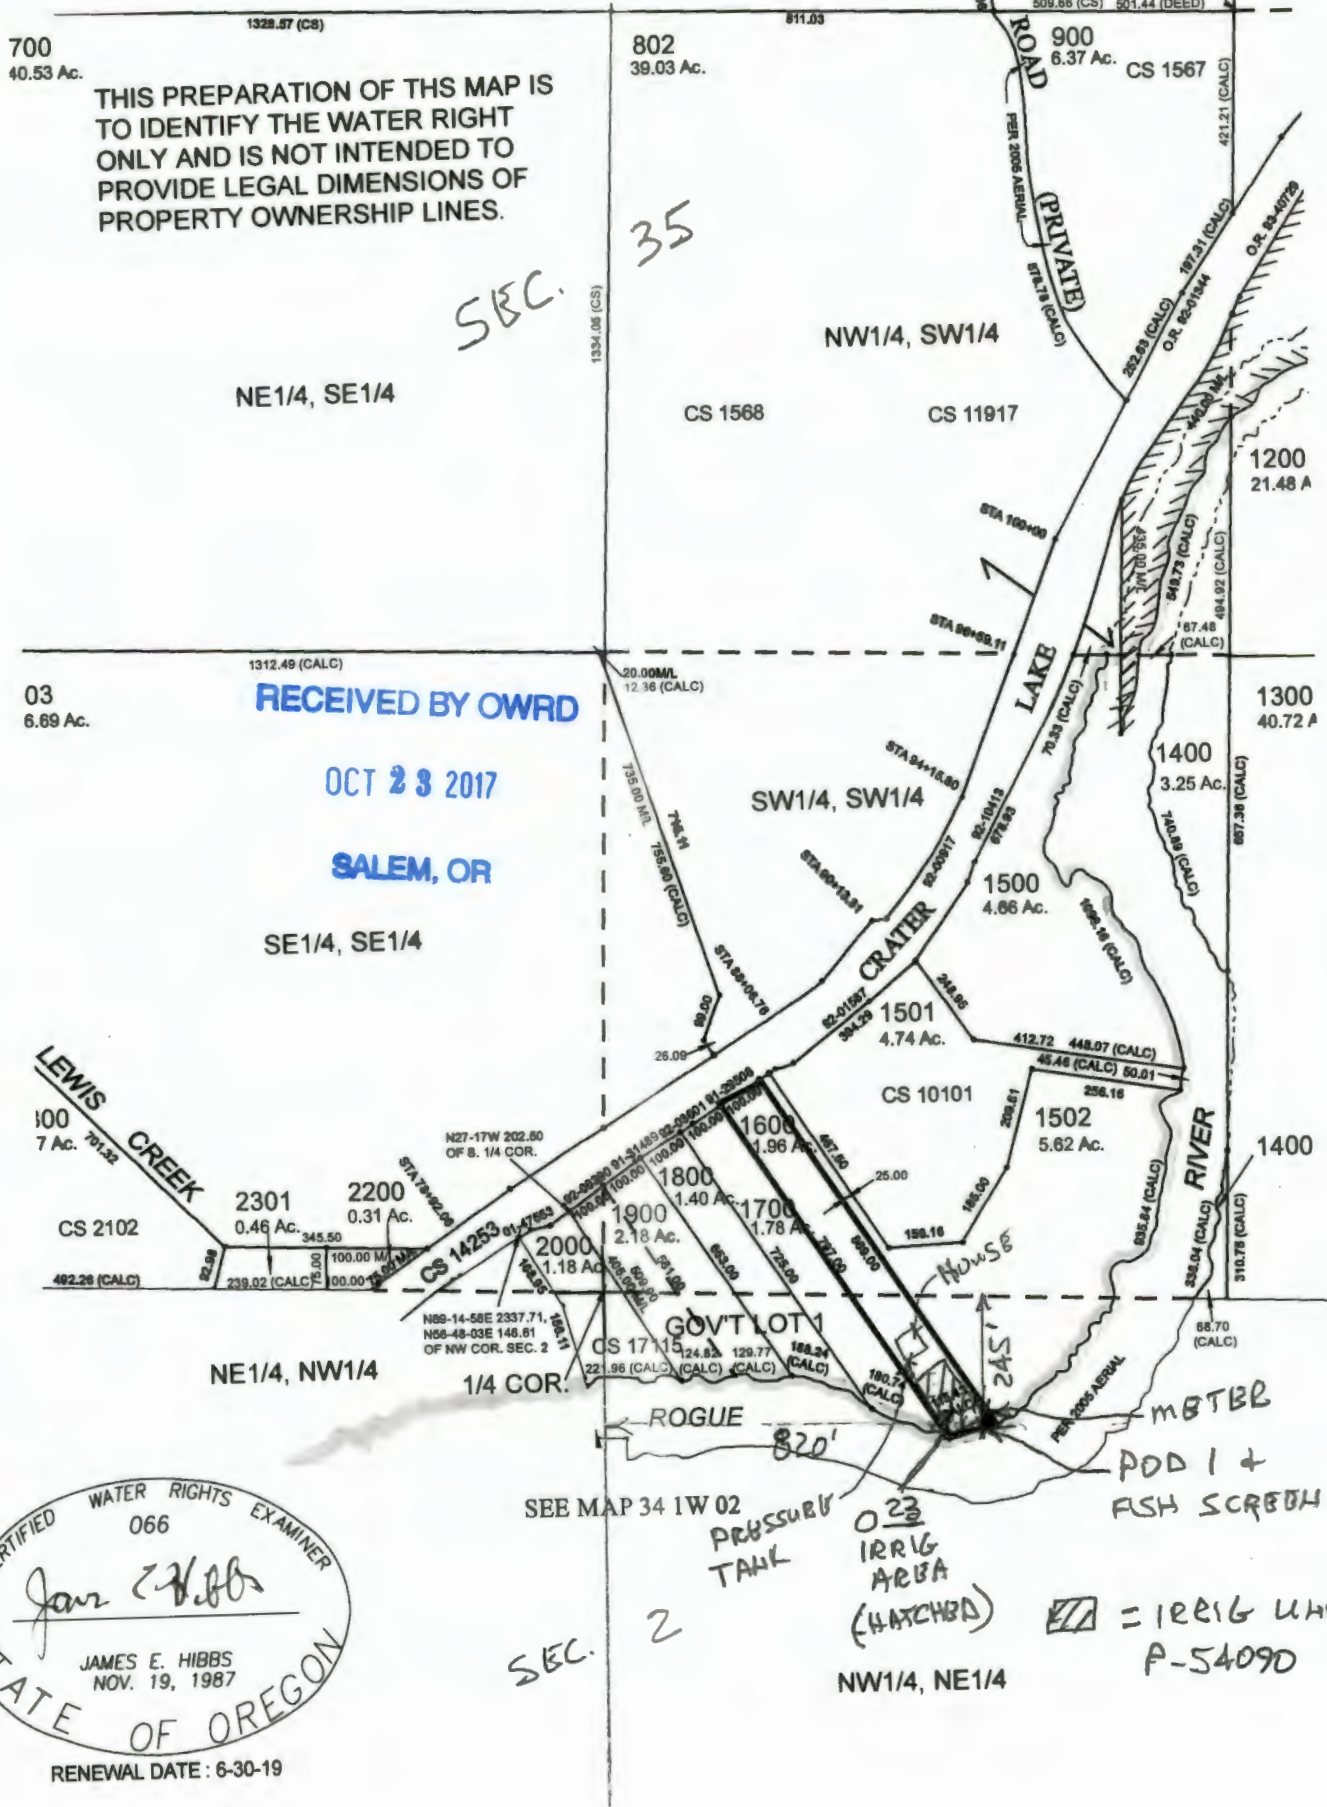

THIS PREPARATION OF THIS MAP IS TO IDENTIFY THE WATER RIGHT ONLY AND IS NOT INTENDED TO PROVIDE LEGAL DIMENSIONS OF PROPERTY OWNERSHIP LINES.

RECEIVED BY OWRD
 OCT 23 2017
 SALEM, OR

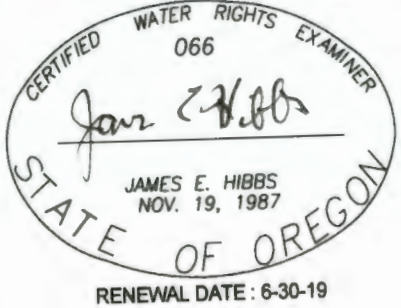

□ = IRRIG UNDER P-54090