


**Map of  
Claim of Beneficial Use  
Great Western Farm and Ranches  
Application G-17178  
Permit G-16555**

T 40 S, R 9 E, Sec. 13 WM

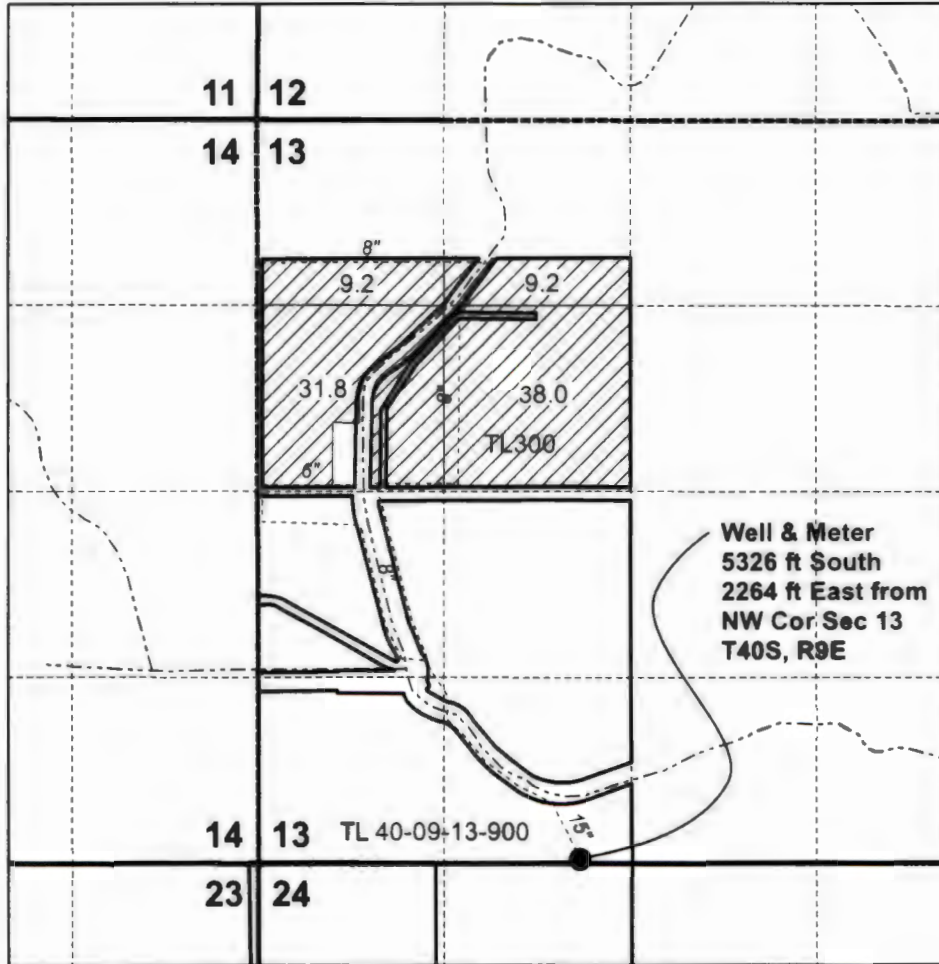




RECEIVED BY OWRD

MAY 19 2017

SALEM, OR

**Legend**

-  Area irrigated
-  Pipeline
-  KID Canals



1 inch = 1,320 feet

Note: This map is not intended to provide legal dimensions or locations of property ownership lines.

