

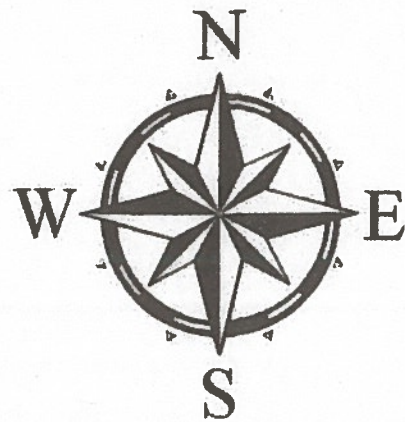


**Map to Accompany Claim of Beneficial Use (COBU) For Application G-16299 and Permit G-15871, NE1/4 & SE 1/4 of SW 1/4 of Section 19, T5S, R1W, WM, Marion Co.**

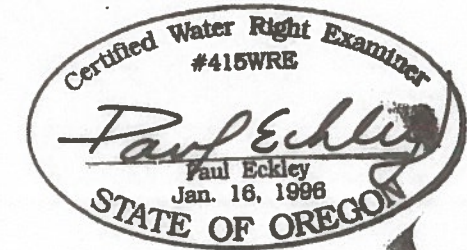

**Scale: 1"=400'**

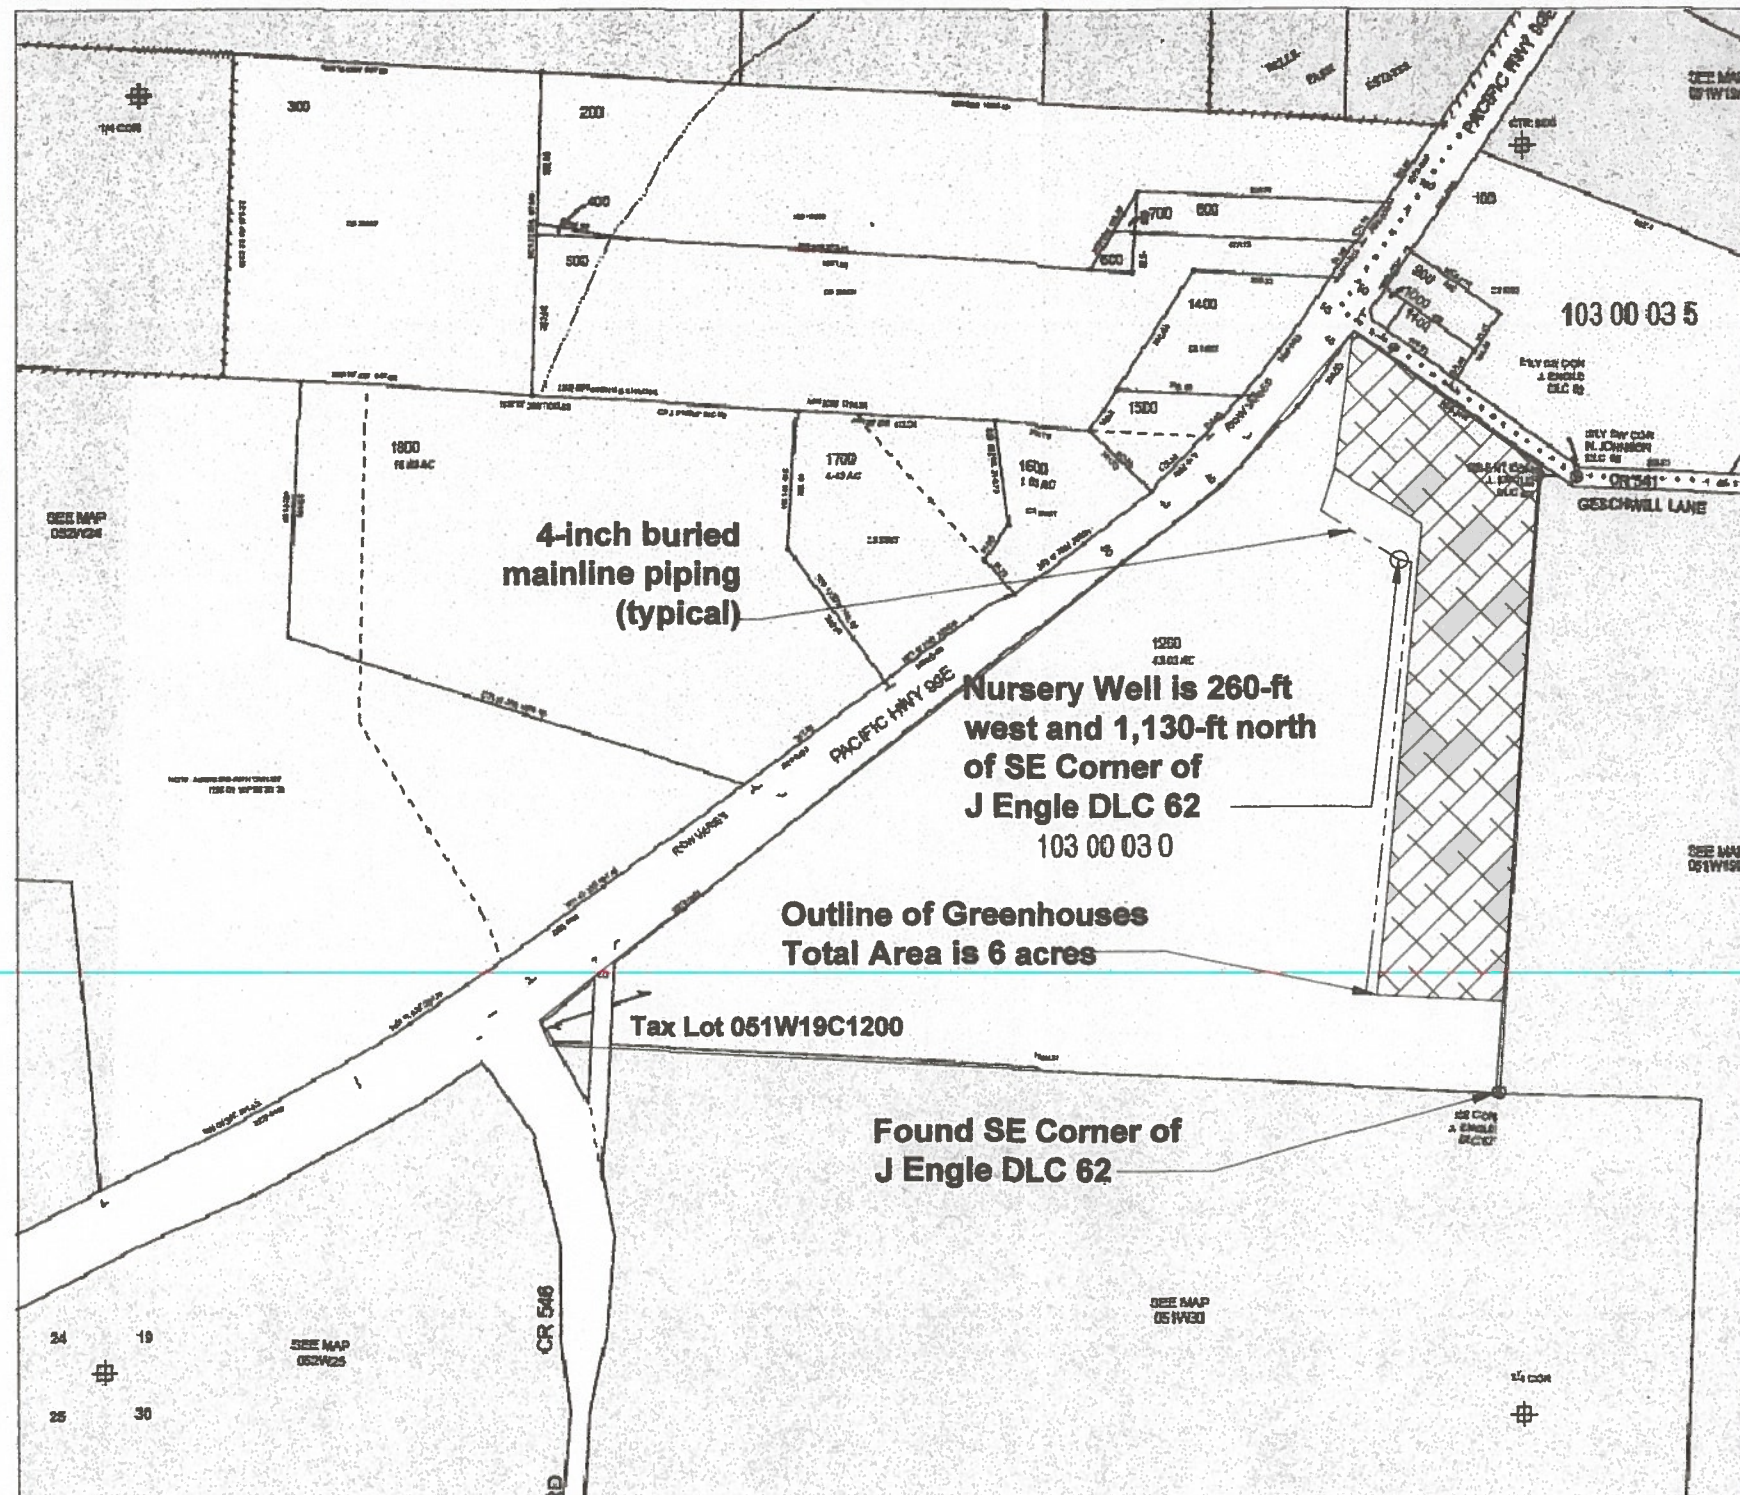

**EXPIRES: 12.31.2017**

**NOTES:**

- 1) This map is not intended to provide legal dimensions or locations of property ownership lines.
- 2) Map prepared for:  
F and B Farms  
10498 Geschill Lane NE  
Woodburn, OR 97071
- 3) Place of Use is 6 acres located in the NE  $\frac{1}{4}$  and SE  $\frac{1}{4}$  of the SW  $\frac{1}{4}$  of Section 19, T5S, R1W, WM.

Map prepared by:

Paul Eckley, CWRE #415WRE  
579 Juntura Court SE  
Salem, Oregon 97302  
(503)580-6476  
pauleckley@comcast.net

**RECEIVED**

NOV 03 2016

WATER RESOURCES DEPT  
SALEM, OREGON