


APPLIC. #	PERMIT #	CERT. #	WELL #
G-9299	G-8746	63587	2
G-11318	G-10481	63588	1,2,3,4
G-11318	G-10481	63588	1,2,3,4
G-4199	G-3964	42787	1
G-11714	G-10846	67909	1,2,3,4
G-12356	G-11216	PENDING	1,2,3,4
G-11868	G-12672	--	1,2,3,4,5
PENDING	PENDING	--	3,4

THIS PERMIT APPLICATION
CLACKAMAS CO., OR
T2S, R4E of WM
SECTION 2
SE of NW = 20.1 AC IRRIG.
SECTION 11
NW of NE = 8.0 AC IRRIG.

RECEIVED

OCT 15 1998



WATER RESOURCES DEPT.
SALEM, OREGON

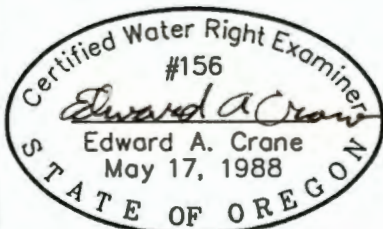

Renewal 12/31/99

Signed 7-30-98

SURVEYED JUL. 15, 1998
BY EDWARD A. CRANE, CWRE

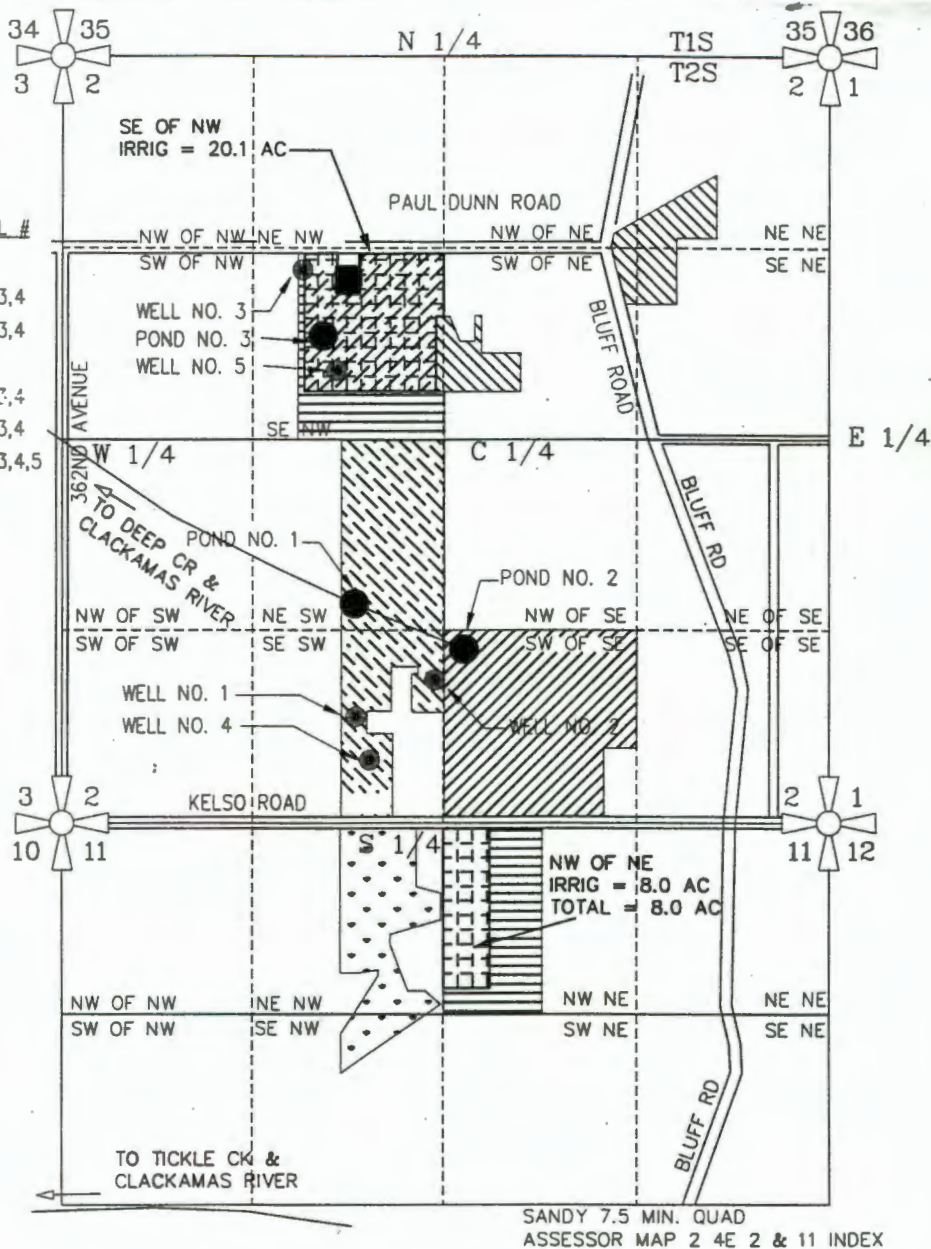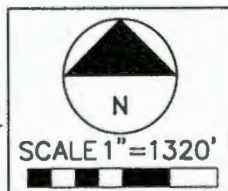

WELL #3 IS LOCATED SOUTH 76 DEGREES EAST 370 FEET FROM THE NW 1/16 CORNER OF SECTION 2, TOWNSHIP 2 SOUTH RANGE 4 EAST OF WM, CLACKAMAS COUNTY, OREGON.
WELL #4 IS LOCATED NORTH 61 DEGREES EAST 905 FEET FROM THE WEST 1/16 CORNER OF SECTION 2, TOWNSHIP 2 SOUTH RANGE 4 EAST OF WM, CLACKAMAS COUNTY, OREGON

PREPARATION OF THIS MAP WAS FOR THE PURPOSE OF IDENTIFYING THE LOCATION OF THE WATER RIGHTS ONLY AND HAS NO INTENT TO PROVIDE DIMENSIONS OR LOCATION OF PROPERTY OWNERSHIP LINES.

FINAL PROOF SURVEY GROUNDWATER PERMIT G-13402

PREPARED BY EDWARD A. CRANE, CWRE

DATE

JULY 1998

PROJECT NO.

252-005



CRANE & MERSETH
Engineering/Surveying

SUITE "D"
6566 SE LAKE ROAD
MILWAUKIE, OREGON 97222

BUS: (503) 654-2005
FAX: (503) 654-2575

APPLICATION FOR PERMIT NUMBER G-14572

PERMIT NUMBER G-13402 IN THE NAME OF:

JAMES & JUDY CHATELAIN
37071 SE KELSO ROAD (TEL. 503-668-7465)
BORING, OREGON 97009 (FAX. 503-668-9151)

SHEET

1/1

RECEIVED

JUN 8 1997

WATER RESOURCES DEPT
SALEM, OREGON


APPLIC. #	PERMIT #	CERT. #	WELL #
G-9299	G-8746	63587	2
G-11318	G-10481	63588	1,2,3,4
G-11318	G-10481	63588	1,2,3,4
G-4199	G-3964	42787	1
G-11714	G-10846	67909	1,2,3,4
G-12356	G-11216	PENDING	1,2,3,4
G-11868	G-12672	--	1,2,3,4,5
PENDING	PENDING	--	3,4

THIS PERMIT APPLICATION
CLACKAMAS CO., OR
T2S, R4E of WM
SECTION 2

SE of NW = 20.1 AC IRRIG.

SECTION 11


NW of NE = 8.0 AC IRRIG.

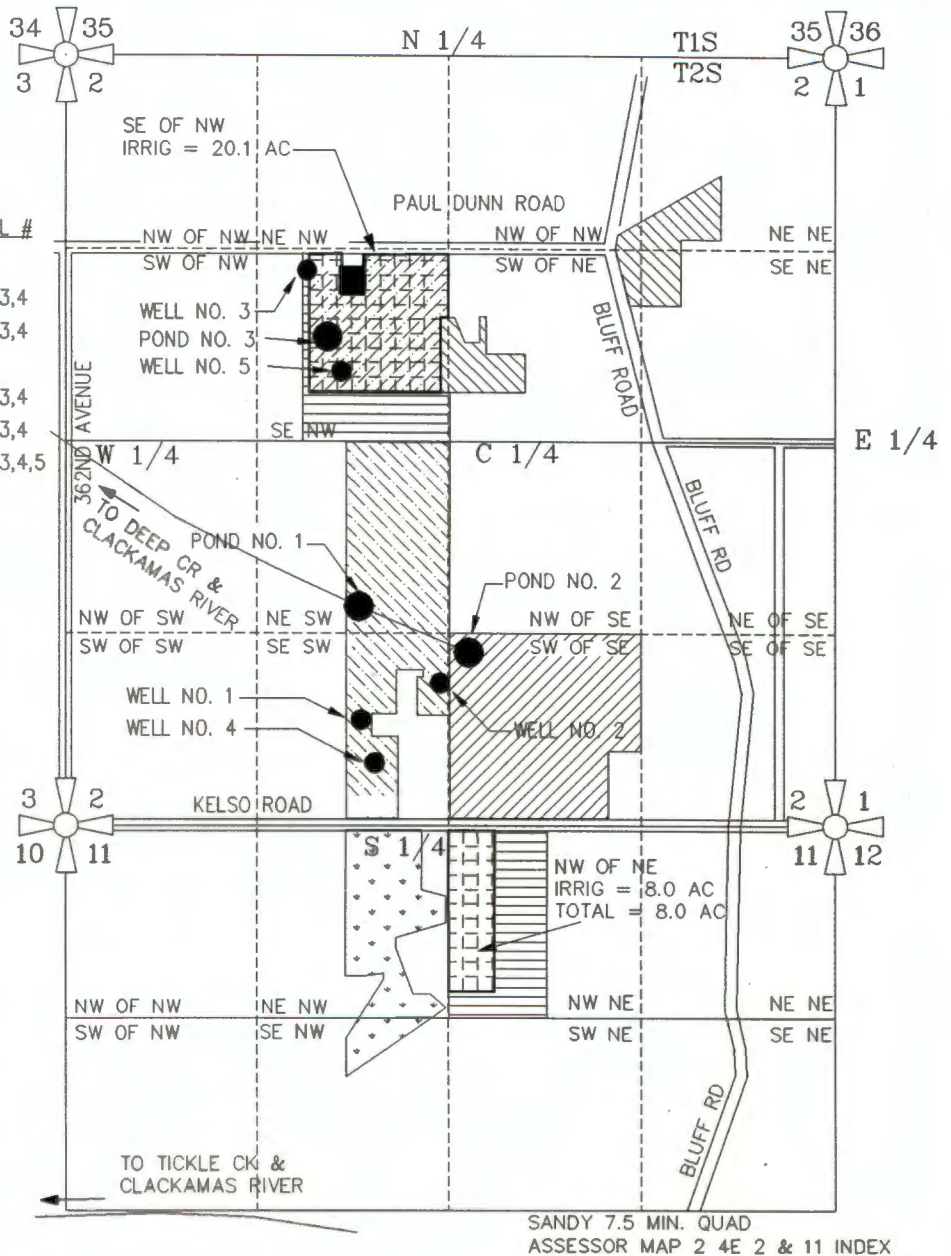

RECEIVED

JUN 11 1997

WATER RESOURCES DEPT
SALEM, OREGON

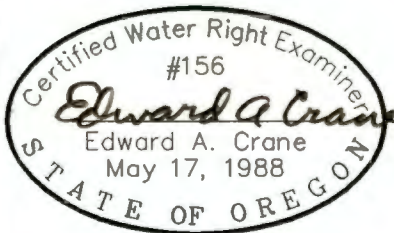


Renewal 12/31/97

Signed 5-20-97

SURVEYED FEB. 10, 1997
BY EDWARD A. CRANE, CWRE

K:\CAD\252-002\25200201.DWG 5/20/97 EAC

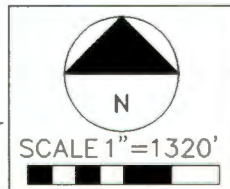

WELL #3 IS LOCATED SOUTH 76 DEGREES EAST 370 FEET FROM THE NW 1/16 CORNER OF SECTION 2, TOWNSHIP 2 SOUTH RANGE 4 EAST OF WM, CLACKAMAS COUNTY, OREGON.
WELL #4 IS LOCATED NORTH 61 DEGREES EAST 905 FEET FROM THE WEST 1/16 CORNER OF SECTION 2, TOWNSHIP 2 SOUTH RANGE 4 EAST OF WM, CLACKAMAS COUNTY, OREGON

PREPARATION OF THIS MAP WAS FOR THE PURPOSE OF IDENTIFYING THE LOCATION OF THE WATER RIGHTS ONLY AND HAS NO INTENT TO PROVIDE DIMENSIONS OR LOCATION OF PROPERTY OWNERSHIP LINES.

APPLICATION FOR A PERMIT
GROUNDWATER PERMIT G-

PREPARED BY EDWARD A. CRANE, CWRE

DATE
FEB. 1997
MAY 1997

PROJECT NO.

252-002



CRANE & MERSETH
Engineering/Surveying
SUITE "D"-
6566 SE LAKE ROAD
MILWAUKIE, OREGON 97222
BUS: (503) 654-2005
FAX: (503) 654-2575

APPLICATION FOR PERMIT NUMBER G-14572
PERMIT NUMBER G-13402 IN THE NAME OF:

JAMES & JUDY CHATELAIN
37071 SE KELSO ROAD (TEL. 503-668-7465)
BORING, OREGON 97009 (FAX. 503-668-9151)

SHEET

1/1