


|  | APPLIC. # | PERMIT # | CERT. # | WELL #    |
|--|-----------|----------|---------|-----------|
|  | G-9299    | G-8746   | 63587   | 2         |
|  | G-11318   | G-10481  | 63588   | 1,2,3,4   |
|  | G-11318   | G-10481  | 63588   | 1,2,3,4   |
|  | G-4199    | G-3964   | 42787   | 1         |
|  | G-11714   | G-10846  | 67909   | 1,2,3,4   |
|  | G-12356   | G-11216  | PENDING | 1,2,3,4   |
|  | G-11868   | G-12672  | --      | 1,2,3,4,5 |
|  | PENDING   | PENDING  | --      | 1,2       |

THIS PERMIT APPLICATION  
CLACKAMAS CO., OR  
T2S, R4E of WM  
SECTION 2

SE of NW = 20.1 AC IRRIG.

SECTION 11

NW of NE = 8.0 AC IRRIG.

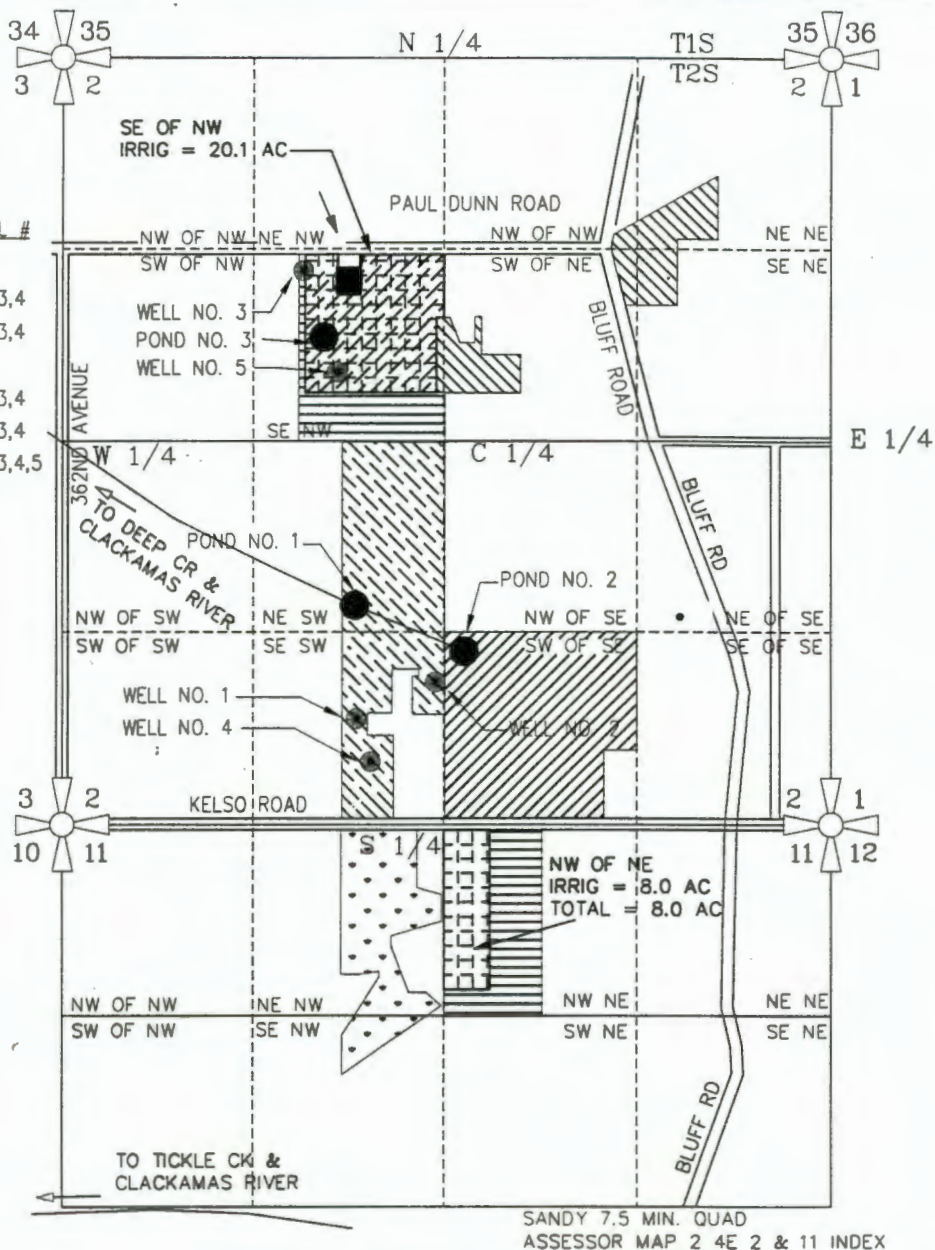


SANDY 7.5 MIN. QUAD  
ASSESSOR MAP 2 4E 2 & 11 INDEX

WELL #1 IS LOCATED NORTH 39 DEGREES WEST 930 FEET FROM THE SOUTH QUARTER CORNER OF SECTION 2, TOWNSHIP 2 SOUTH RANGE 4 EAST OF WM, CLACKAMAS COUNTY, OREGON.  
WELL #2 IS LOCATED SOUTH 7 DEGREES WEST 350 FEET FROM THE CENTER-SOUTH 1/16 CORNER OF SECTION 2, TOWNSHIP 2 SOUTH RANGE 4 EAST OF WM, CLACKAMAS COUNTY, OREGON

PREPARATION OF THIS MAP WAS FOR THE PURPOSE OF IDENTIFYING THE LOCATION OF THE WATER RIGHTS ONLY AND HAS NO INTENT TO PROVIDE DIMENSIONS OR LOCATION OF PROPERTY OWNERSHIP LINES.

FINAL PROOF SURVEY  
GROUNDWATER PERMIT G-13403


PREPARED BY EDWARD A. CRANE, CWRE

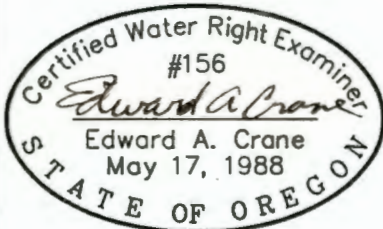

Renewal 12/31/99

Signed 7-30-98

SURVEYED JUL. 15, 1998  
BY EDWARD A. CRANE, CWRE

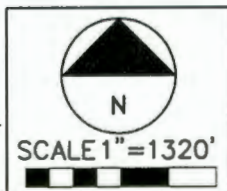

DATE

JULY 1998

PROJECT NO.

252-004



CRANE & MERSETH

Engineering/Surveying

SUITE "D"  
6566 SE LAKE ROAD  
MILWAUKIE, OREGON 97222

BUS: (503) 654-2005  
FAX: (503) 654-2575

APPLICATION FOR PERMIT NUMBER G-14573

PERMIT NUMBER G-13403 IN THE NAME OF:

JAMES & JUDY CHATELAIN  
37071 SE KELSO ROAD (TEL. 503-668-7465)  
BORING, OREGON 97009 (FAX. 503-668-9151)

SHEET

1/1

RECEIVED

JUN 24 1997

WATER RESOURCES DEPT.  
SALEM, OREGON

| APPLIC. # | PERMIT # | CERT. # | WELL #    |
|-----------|----------|---------|-----------|
| G-9299    | G-8746   | 63587   | 2         |
| G-11318   | G-10481  | 63588   | 1,2,3,4   |
| G-11318   | G-10481  | 63588   | 1,2,3,4   |
| G-4199    | G-3964   | 42787   | 1         |
| G-11714   | G-10846  | 67909   | 1,2,3,4   |
| G-12356   | G-11216  | PENDING | 1,2,3,4   |
| G-11868   | G-12672  | --      | 1,2,3,4,5 |
| PENDING   | PENDING  | --      | 1,2       |

THIS PERMIT APPLICATION

CLACKAMAS CO., OR

T2S, R4E of WM

SECTION 2

SE of NW = 20.1 AC IRRIG.


SECTION 11

NW of NE = 8.0 AC IRRIG.

RECEIVED

JUL - 9 1997

WATER RESOURCES DEPT.  
SALEM, OREGON

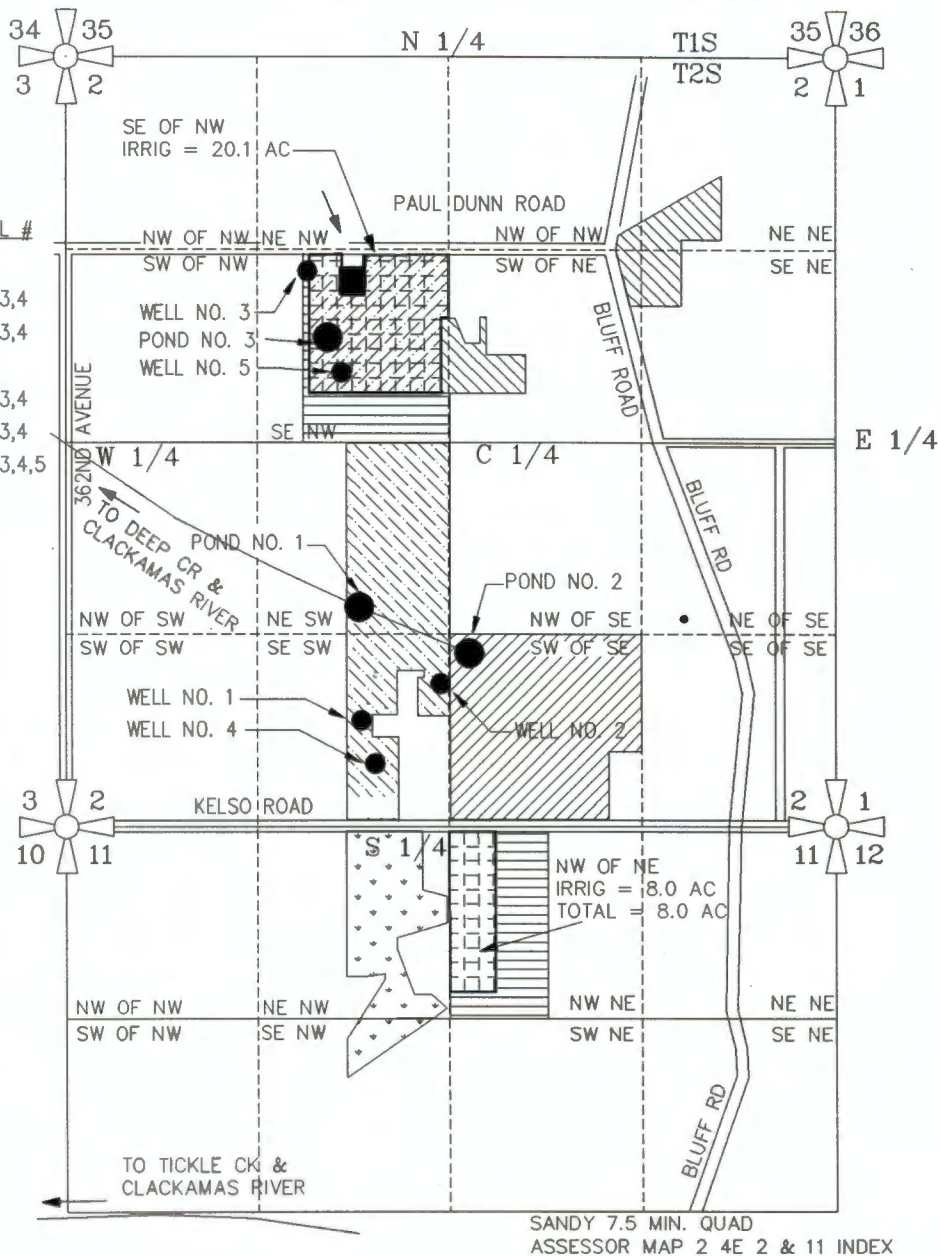


WELL #1 IS LOCATED NORTH 39 DEGREES WEST 930 FEET FROM THE SOUTH QUARTER CORNER OF SECTION 2, TOWNSHIP 2 SOUTH RANGE 4 EAST OF WM, CLACKAMAS COUNTY, OREGON.  
WELL #2 IS LOCATED SOUTH 7 DEGREES WEST 350 FEET FROM THE CENTER-SOUTH 1/16 CORNER OF SECTION 2, TOWNSHIP 2 SOUTH RANGE 4 EAST OF WM, CLACKAMAS COUNTY, OREGON

PREPARATION OF THIS MAP WAS FOR THE PURPOSE OF IDENTIFYING THE LOCATION OF THE WATER RIGHTS ONLY AND HAS NO INTENT TO PROVIDE DIMENSIONS OR LOCATION OF PROPERTY OWNERSHIP LINES.


APPLICATION FOR A PERMIT  
GROUNDWATER PERMIT G-

PREPARED BY EDWARD A. CRANE, CWRE

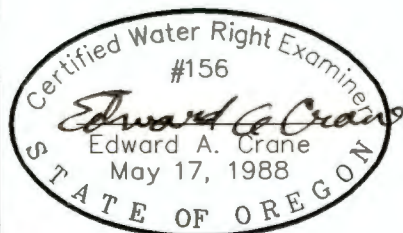

Renewal 12/31/97  
Signed *5.20.97*

SURVEYED FEB. 10, 1997  
BY EDWARD A. CRANE, CWRE

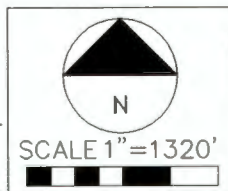

DATE  
FEB. 1997  
MAY 1997

PROJECT NO.

252-002



CRANE & MERSETH  
Engineering/Surveying  
SUITE "D"  
6566 SE LAKE ROAD  
MILWAUKIE, OREGON 97222  
BUS: (503) 654-2005  
FAX: (503) 654-2575

APPLICATION FOR PERMIT NUMBER G-014573 SHEET  
PERMIT NUMBER G-13403 IN THE NAME OF:

JAMES & JUDY CHATELAIN  
37071 SE KELSO ROAD (TEL. 503-668-7465)  
BORING, OREGON 97009 (FAX. 503-668-9151)

1/1