


T 27 S, R 31 E, WM
R 32 E,

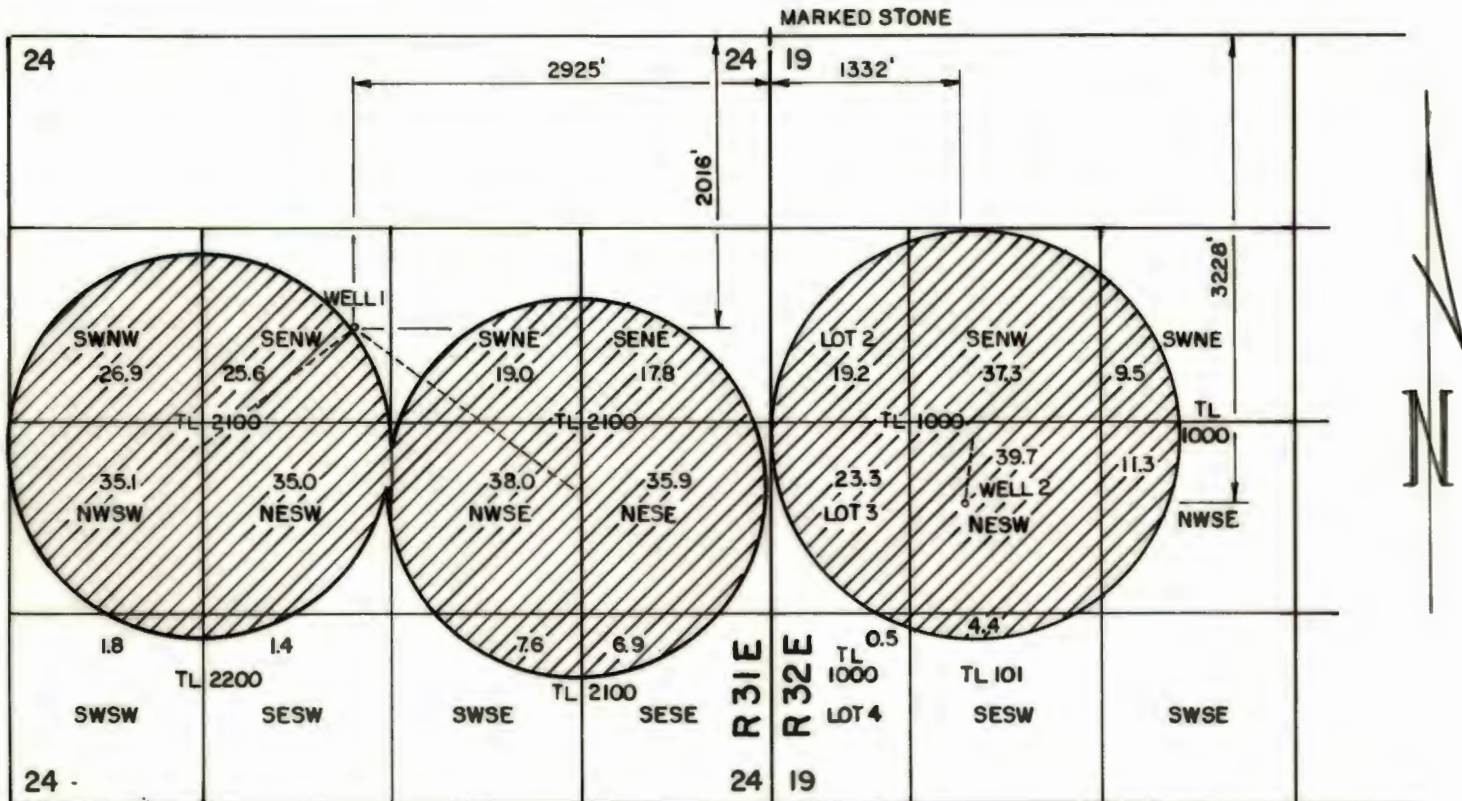


DEDICATED ELEC. METER POLE IS 8'E FROM WELL 1.
FLOW METER IS 7'N, 1'E FROM WELL 2.

THE PURPOSE OF THIS MAP IS TO IDENTIFY THE LOCATION OF THE WATER RIGHT. IT IS NOT INTENDED TO DEFINE IN DETAIL RELATIVE TO THE LOCATION OF PROPERTY OWNERSHIP.

RECEIVED


WATER RESOURCES DEPT
SALEM, OREGON

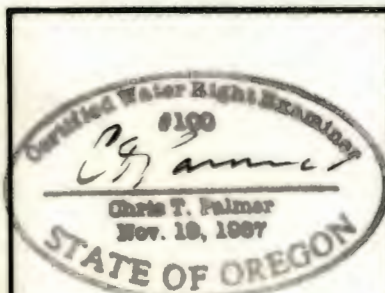

FINAL PROOF SURVEY

UNDER
APPLICATION G-14899
PERMIT G-13731

IN THE NAME OF
TOM DAVIS

Scale: 4" = 1 MILE

Date: **AUG. 2008**

Job: 2515A

Dsn:

MAP's

M.A. PALMER & SONS, INC.
ENGINEERING & SURVEYING
711 Ponderosa Village • Box 61
Burns, Oregon 97720

Sht. No.

Drn: CHRIS

Ckd:

of 1

RENEW 1-1-2011