



T.2S. R.6E. Sec. 20 & 29, W.M.

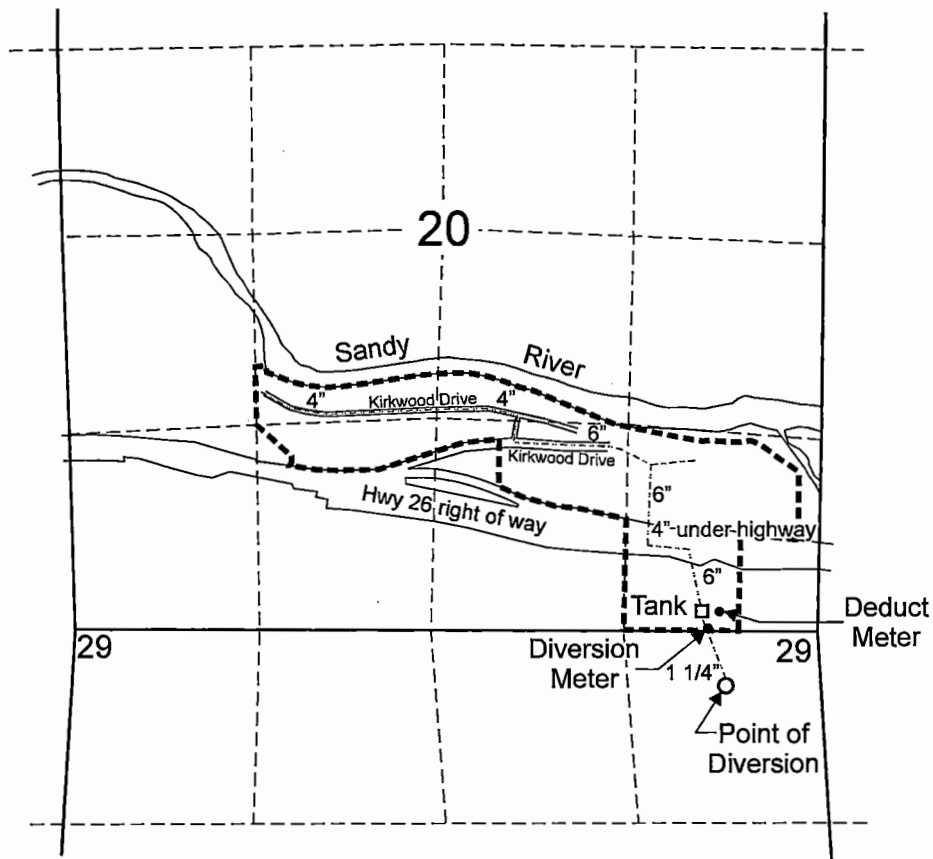


Point of diversion (spring) is located 370 feet south and 630 feet west from the NE corner of Section 29.

----- Boundary of area served by Riverside Water District

RECEIVED
SEP 22 2011
WATER RESOURCES DEPT
SALEM, OREGON

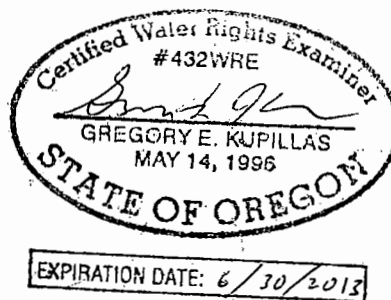

Scale: 1" = 1,320'

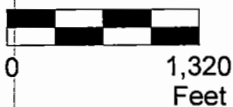

This map was prepared for the purpose of identifying the location of a water right only and is not intended to provide legal dimensions or location of property ownership lines.

Claim of Beneficial Use Map
T-10697

Riverside Water District
T.2S. R.6E. Sec. 20 and 29, W.M.

Pacific Hydro-Geology Inc.

9/2011