


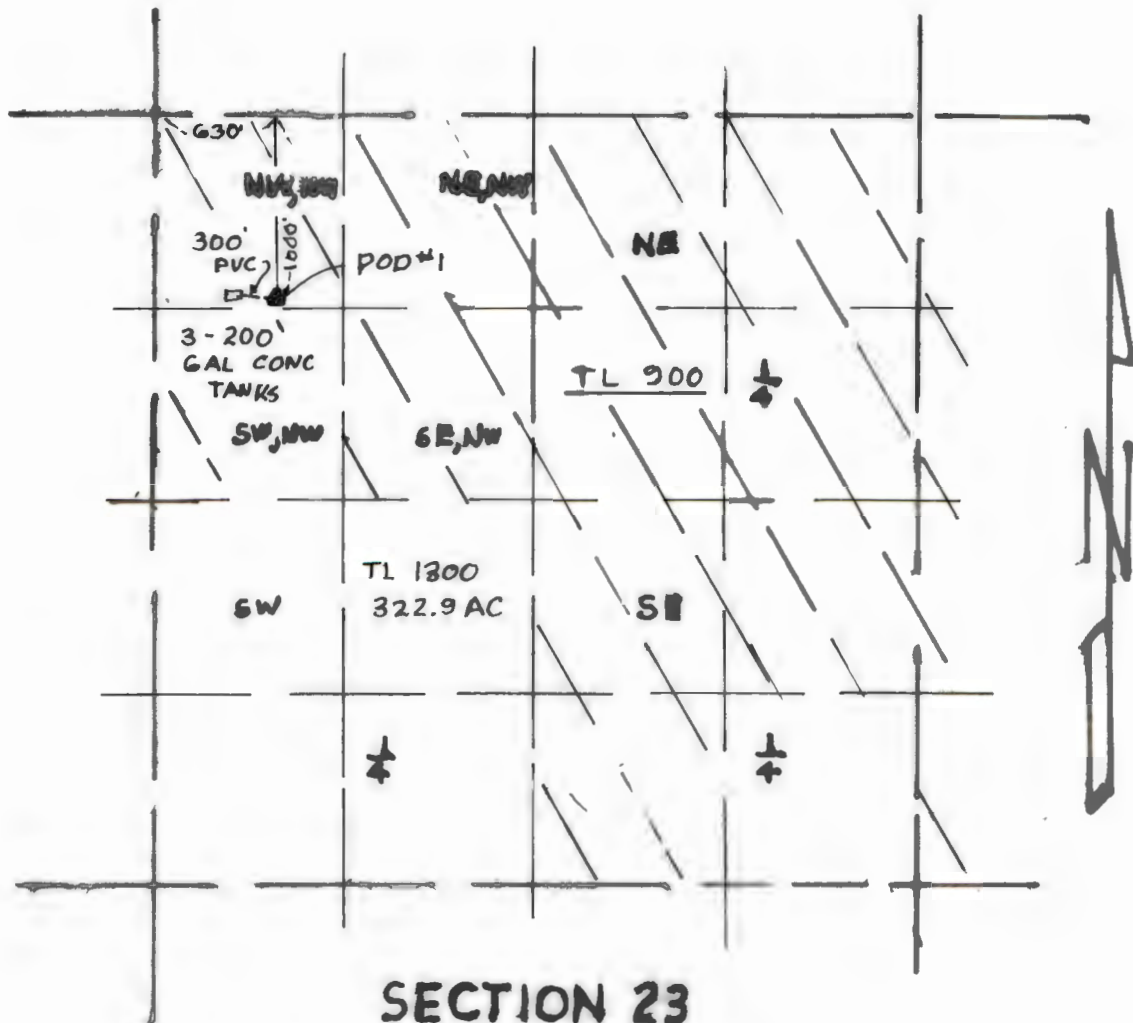

SECTION 23

T.1 N., R.30 E.W.M.

RECEIVED BY OWRD

THIS MAP IS FOR WATER
RIGHT INFORMATION ONLY

OCT 28 2016

SALEM, OR

KRUMBEIN ENGINEERING LTD.
ENGINEERS - SURVEYORS - PLANNERS
361. S.E. Second Pendleton, Oregon

Scale 1"=1320'	Dwn. By DJK	Drng. No. 1621A	Revision 1
Date 10-24-16	Ckd. By	Job No. 1664	Revision 2

POD 1 - PERMIT S-54170


PETERSON

SEC. 23, T.1N., R.30E.W.M
UMATILLA COUNTY, OR



REVISED 6/30/2016

FINAL PROOF MAP

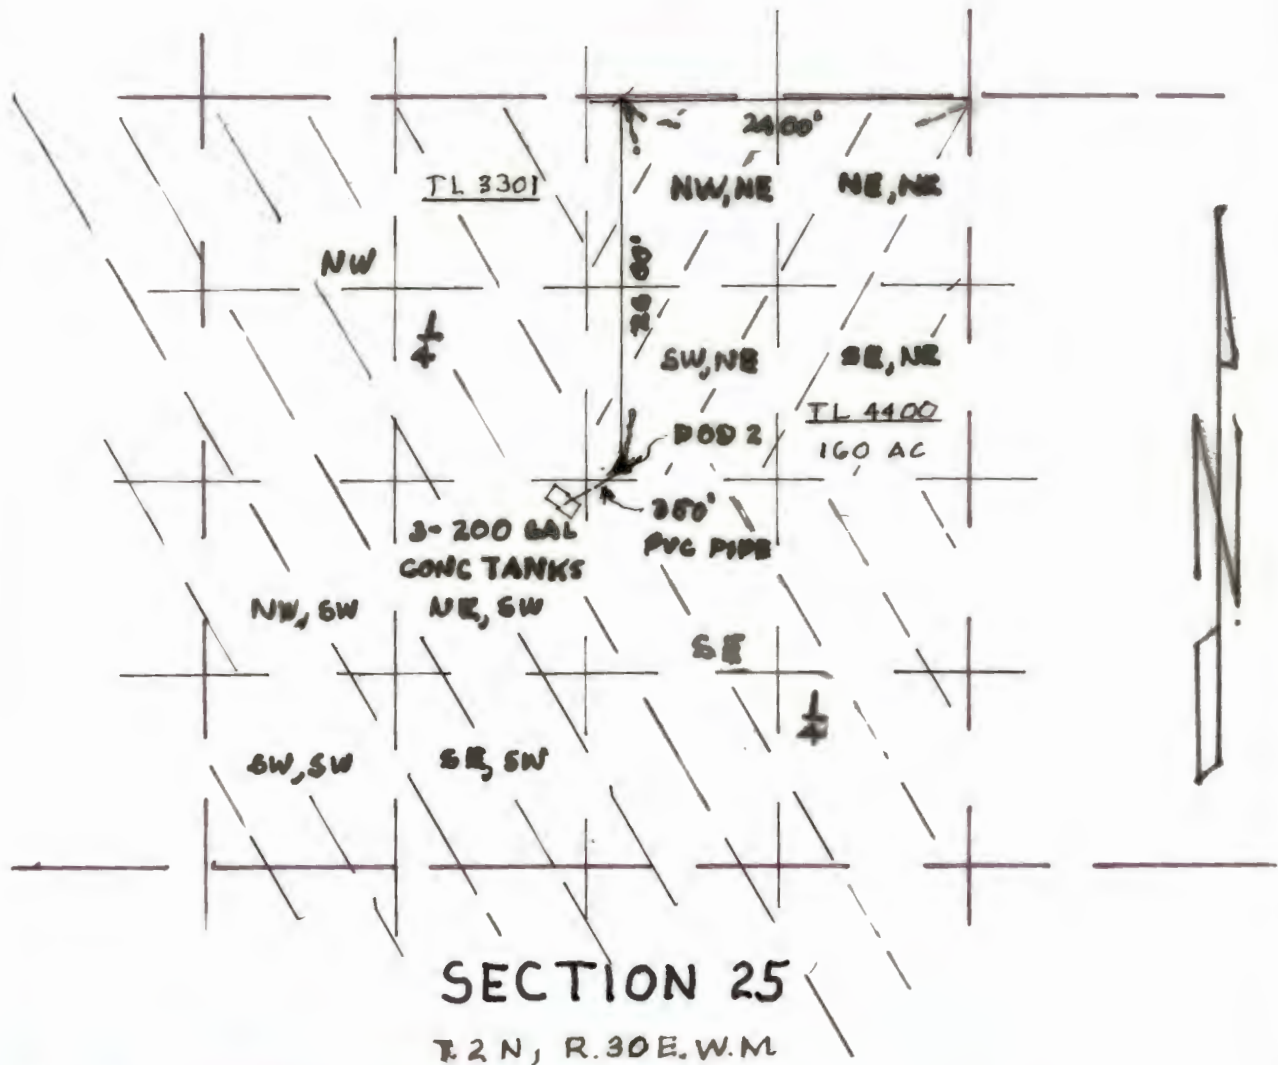

THIS MAP IS FOR WATER RIGHT INFORMATION ONLY

K KRUMBEIN ENGINEERING LTD. ENGINEERS - SURVEYORS - PLANNERS 361. S.E. Second Pendleton, Oregon	Scale 1" = 1320'	Dwn. By DHK	Dwg. No. 1620A	Revision 1
	Date 10-21-16	Ckd. By	Job No. 1664	Revision 2

POD 2 - PERMIT 5-54170 PETERSON SEC. 25, T.2N., R.30E.W.M. UMATILLA COUNTY, OR	 RENEWS 6/30/2017	FINAL PROOF MAP RECEIVED BY OWRD OCT 28 2016 SALEM, OR
--	--------------------------	---