


NOTES

THIS MAP DOES NOT CONSTITUTE A BOUNDARY SURVEY.

THE PURPOSE OF THIS MAP IS TO SHOW THE POINT OF DIVERSION, WATER SYSTEM, AND HOUSE FOR APPLICATION # S-87887, PERMIT # S-54888.

1" BLACK POLLY WATER PIPE
LENGTH = 1180'

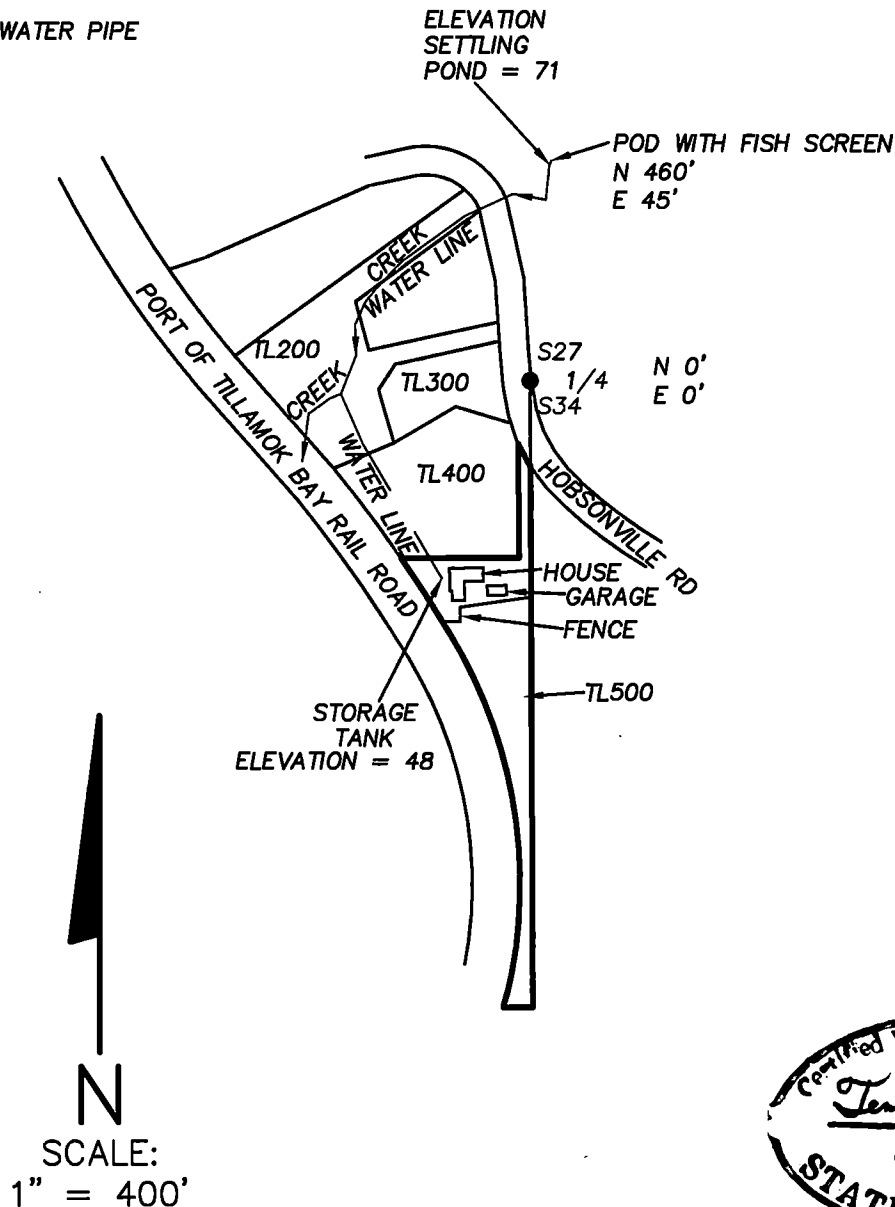

RECEIVED BY OWRD

JUL 27 2016

SALEM, OR

RENEWAL DATE JUNE 30, 2017

SURVEY BY:
BAYSIDE SURVEYING
11765 HWY 101 SOUTH
TILLAMOOK, OR. 97141
(503) 842-5551

WATER RIGHTS MAP FOR:

BRYAN GIBSON

TAX LOT 500
NW 1/4 SECTION 34,
T1N, R10W, W.M.

TILLAMOOK COUNTY, OREGON

SITE\GIBSONWR.DWG
HARPHALE.CR5

DATE	EQUIPMENT	FIELD	DRAWN	CHECKED	JOB NO.
JULY 8, 2016	TOPCON ES-103 SPECTRA NOMAD	TLJ/DWE	DWE	TLJ	