

MAP FOR Claim of Beneficial Use

SE 1/4, S18, T6S, R2W, MARION COUNTY
APPLICATION G-14287, PERMIT G-13759

C1/4
CORNER
S18

E 1/4
CORNER
S18


DIVIDING LINE
BETWEEN TAX
LOTS 500 & 601 =
DONATION LAND
CLAIM (DLC) LINE

EXTERIOR
BOUNDARY
TAX LOTS 500 &
601

TAXLOT
601

TAXLOT
500

INTERSTATE HIGHWAY 5

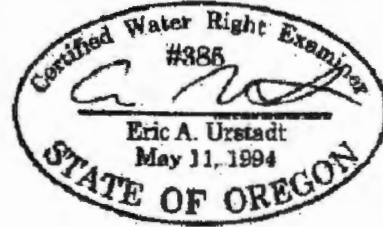

NW-SE
SW-SE

NE-SE
SE-SE

THIS MAP IS NOT INTENDED TO
PROVIDE LEGAL DIMENSIONS
OR LOCATIONS OF PROPERTY
OWNERSHIP LINES.

NOTES:

- THE SECTION, DLC, AND PROPERTY LINES ARE FROM A SCALED TAX ASSESSOR MAP.
- THE WELL LOCATION WAS DETERMINED FROM AERIAL PHOTO INTERPRETATION.
- WELL COORDINATES ARE DIFFERENT THAN FROM THE PERMIT, BUT THE WELL LOCATION HAS NOT MOVED.
- WATER CONVEYANCE PIPELINES ARE NOT SHOWN; ALL ARE WITHIN THE PROPERTY OWNERSHIP.

DLC PETIT #75
DLC BROOKS #64

SE CORNER
DLC #75

S 1/4
CORNER
S18

SE
CORNER
S18

FEET FROM SE CORNER S18		
WELL	NORTH	WEST
	1810	1800

LEGEND

- ▲ DONATION LAND CLAIM (DLC) CORNER RECEIVED BY OWRD
- ◆ SECTION OR QUARTER CORNER
- ⊙ WELL, TANK, FILTRATION SYSTEM

AUG 01 2016

SALEM, OR

MAP FOR:
PILOT TRAVEL CENTERS

MAP BY:
**ASPEN RURAL LAND
CONSULTING**

ERIC URSTADT, PE, PLS
971-250-1520
JUNE 2015
BROADBENT-PILOT

