



RECEIVED
FEB 04 2019
OWRD

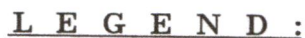


-  AC. AREA "FROM" LOCATION = 5.8 AC.
 () AREA "TO" LOCATION = 5.8 AC.
 [] AREA TO BE CANCELED = 1.0 AC.

TRANSFER APPLICATION MAP

 

SECTIONS 4 & 9, TWP.11 S. RANGE 22 E. W.M.
WHEELER COUNTY, OREGON

RECEIVED
FEB 04 2019
OWRD

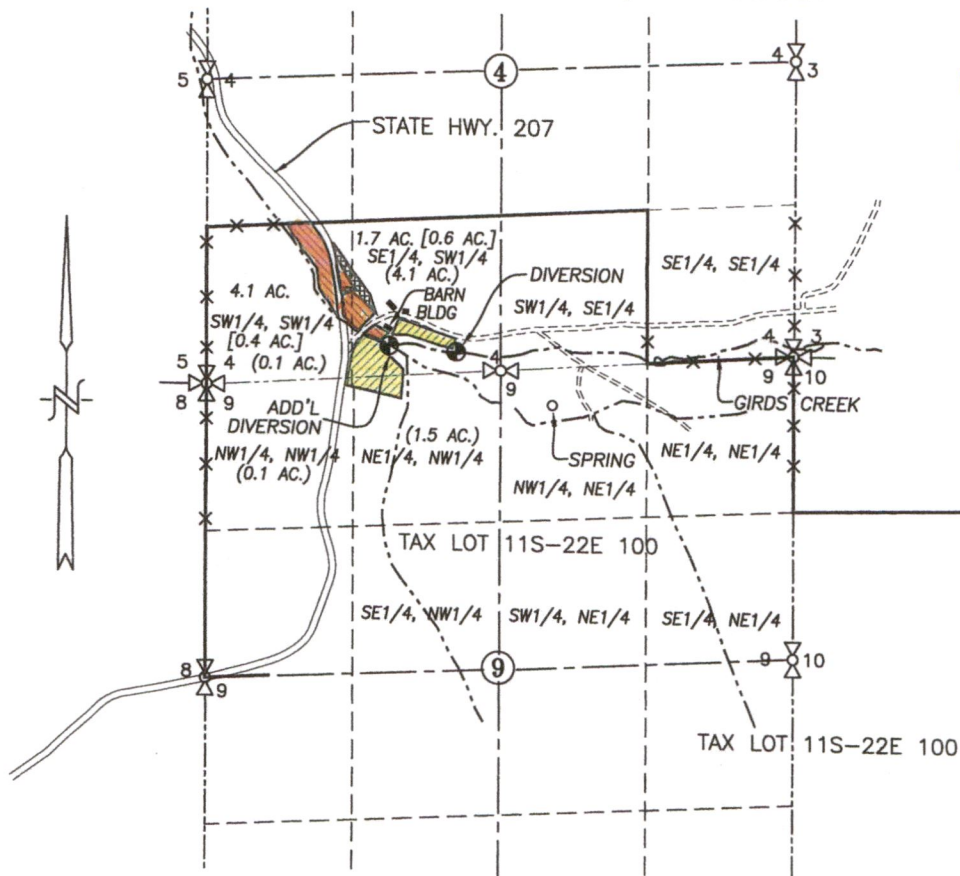

LEGEND:

- EXISTING SPRING: 140' S. & 3,110' E. OF SW CORNER SECTION 4
- ⊕ EXISTING DIVERSION: 326' N. & 2,240' E. OF SW CORNER SECTION 4
- ⊕ ADDITIONAL DIVERSION: 367' N. & 1,637' E. OF SW CORNER SECTION 4
- AC. AREA "FROM" LOCATION = 5.8 AC.
- () AREA "TO" LOCATION = 5.8 AC.
- [] AREA TO BE CANCELED = 1.0 AC.
- STREAM WITH DIRECTIONAL FLOW
- EXISTING FENCE LINE

TRANSFER APPLICATION MAP

SCALE: 1" = 1320'
0' 660' 1320' 2640'


TRANSFER No. _____

IN THE NAME OF:

SIX SHOOTER RANCH, LLC

DATE: DECEMBER 27, 2018

BY: **TENNESON ENGINEERING CORP.**
3775 CRATES WAY
THE DALLES, OREGON. 97058
PH. 541-296-9177
FAX 541-296-6657

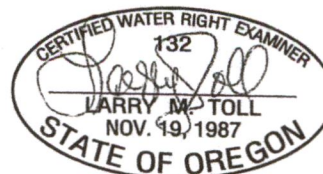


EXPIRES: 06/30/2020

NOTE:

"THIS MAP IS NOT INTENDED TO PROVIDE LEGAL DIMENSIONS OR LOCATIONS OF PROPERTY OWNERSHIP LINES."

W.O. #15336wr

TOWNSHIP 11 S., RANGE 22

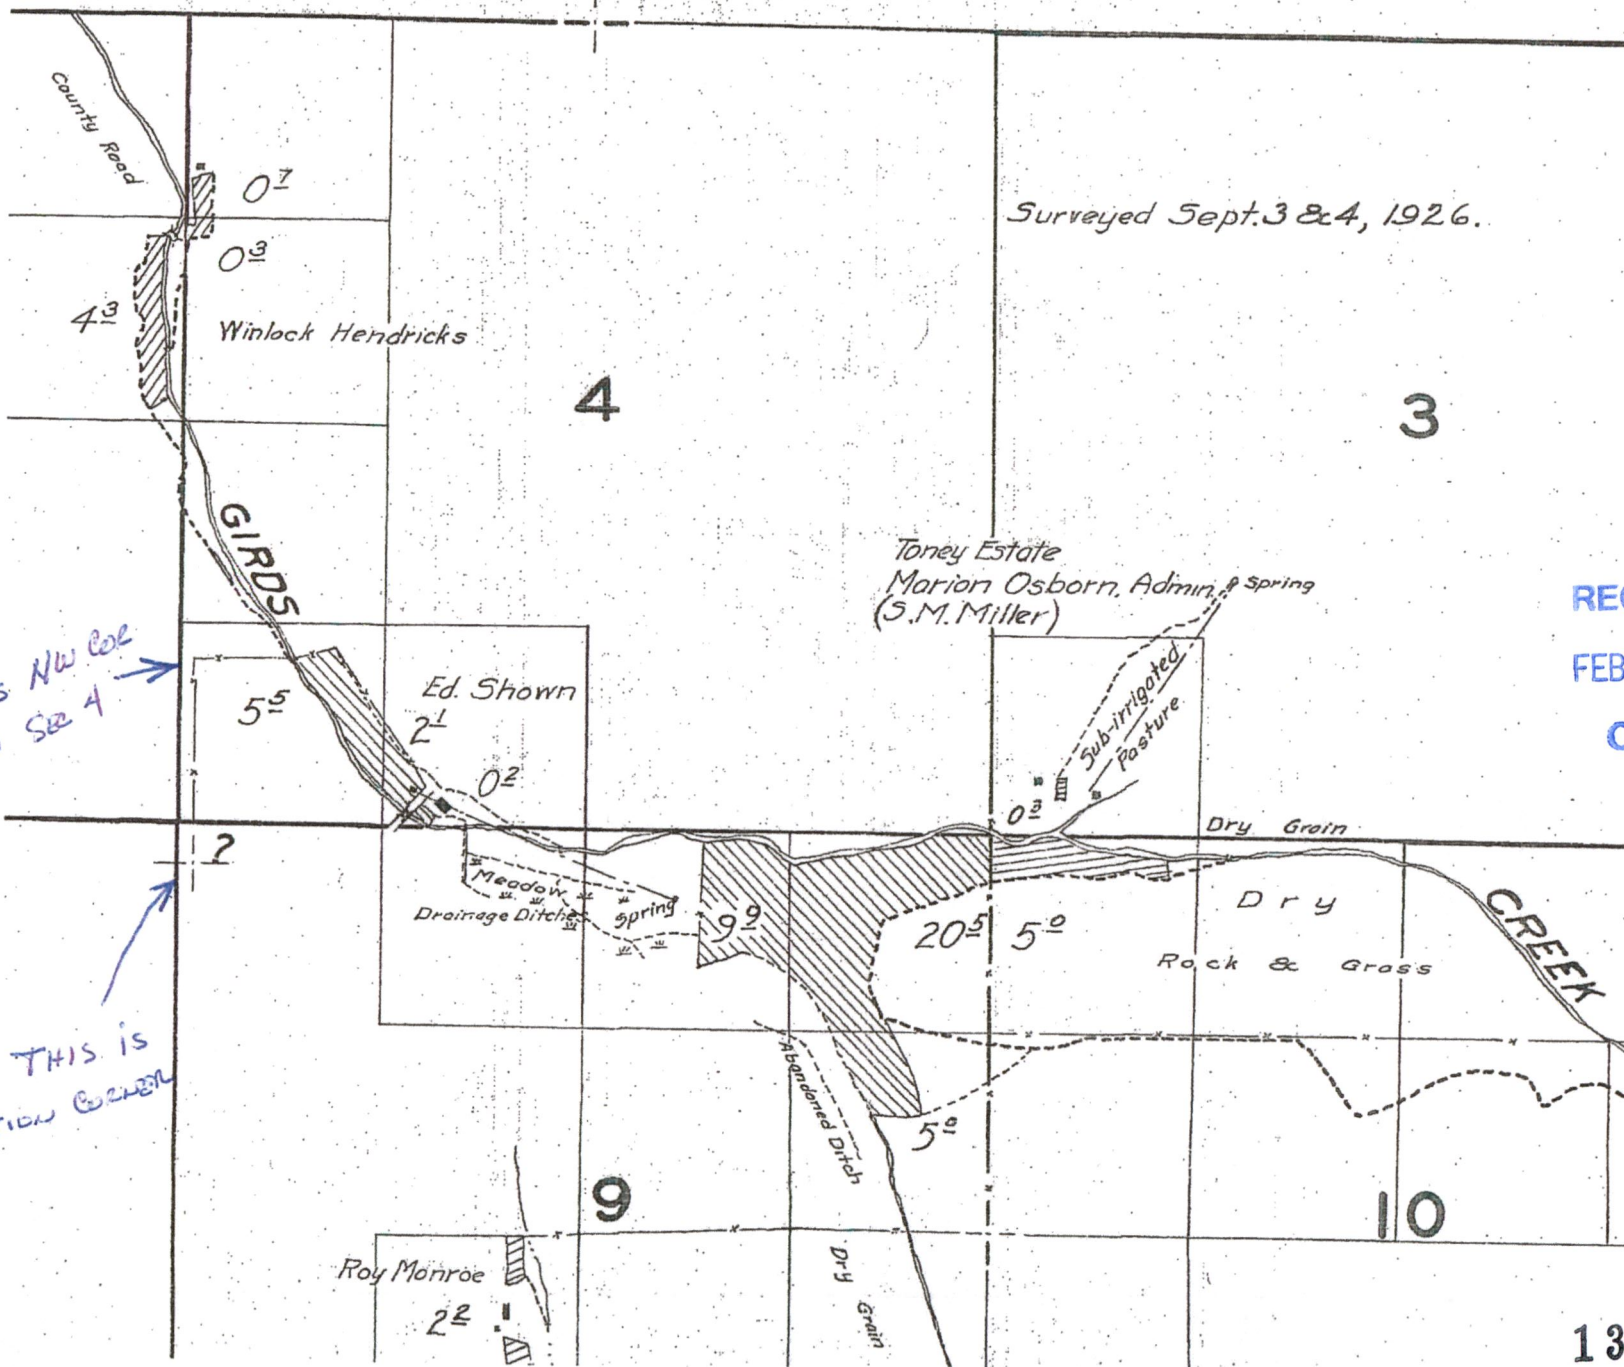

Surveyed Sept. 3 & 4, 1926.

RECEIVED

FEB 04 2019

OWRD

THIS IS NW COR
of SW of SW SEC 4 →

BELIEVE THIS IS
SECTION CORNER

13118

Six Shooter Ranch^(?)

image date is 2017

PLS
FENCES
IN AREA

Legend

NW COR
SW of SW
Sec 4

4x3
9 10

RECEIVED
FEB 04 2019
OWRD

13118



2000 ft

Google Earth



13118


THIS MAP WAS PREPARED FOR
ASSESSMENT PURPOSE ONLY

0 450 900 1,800 Feet

T.11S. R.22E. W.M.
WHEELER COUNTY
1" = 2000'

11S22E

1/29/2018

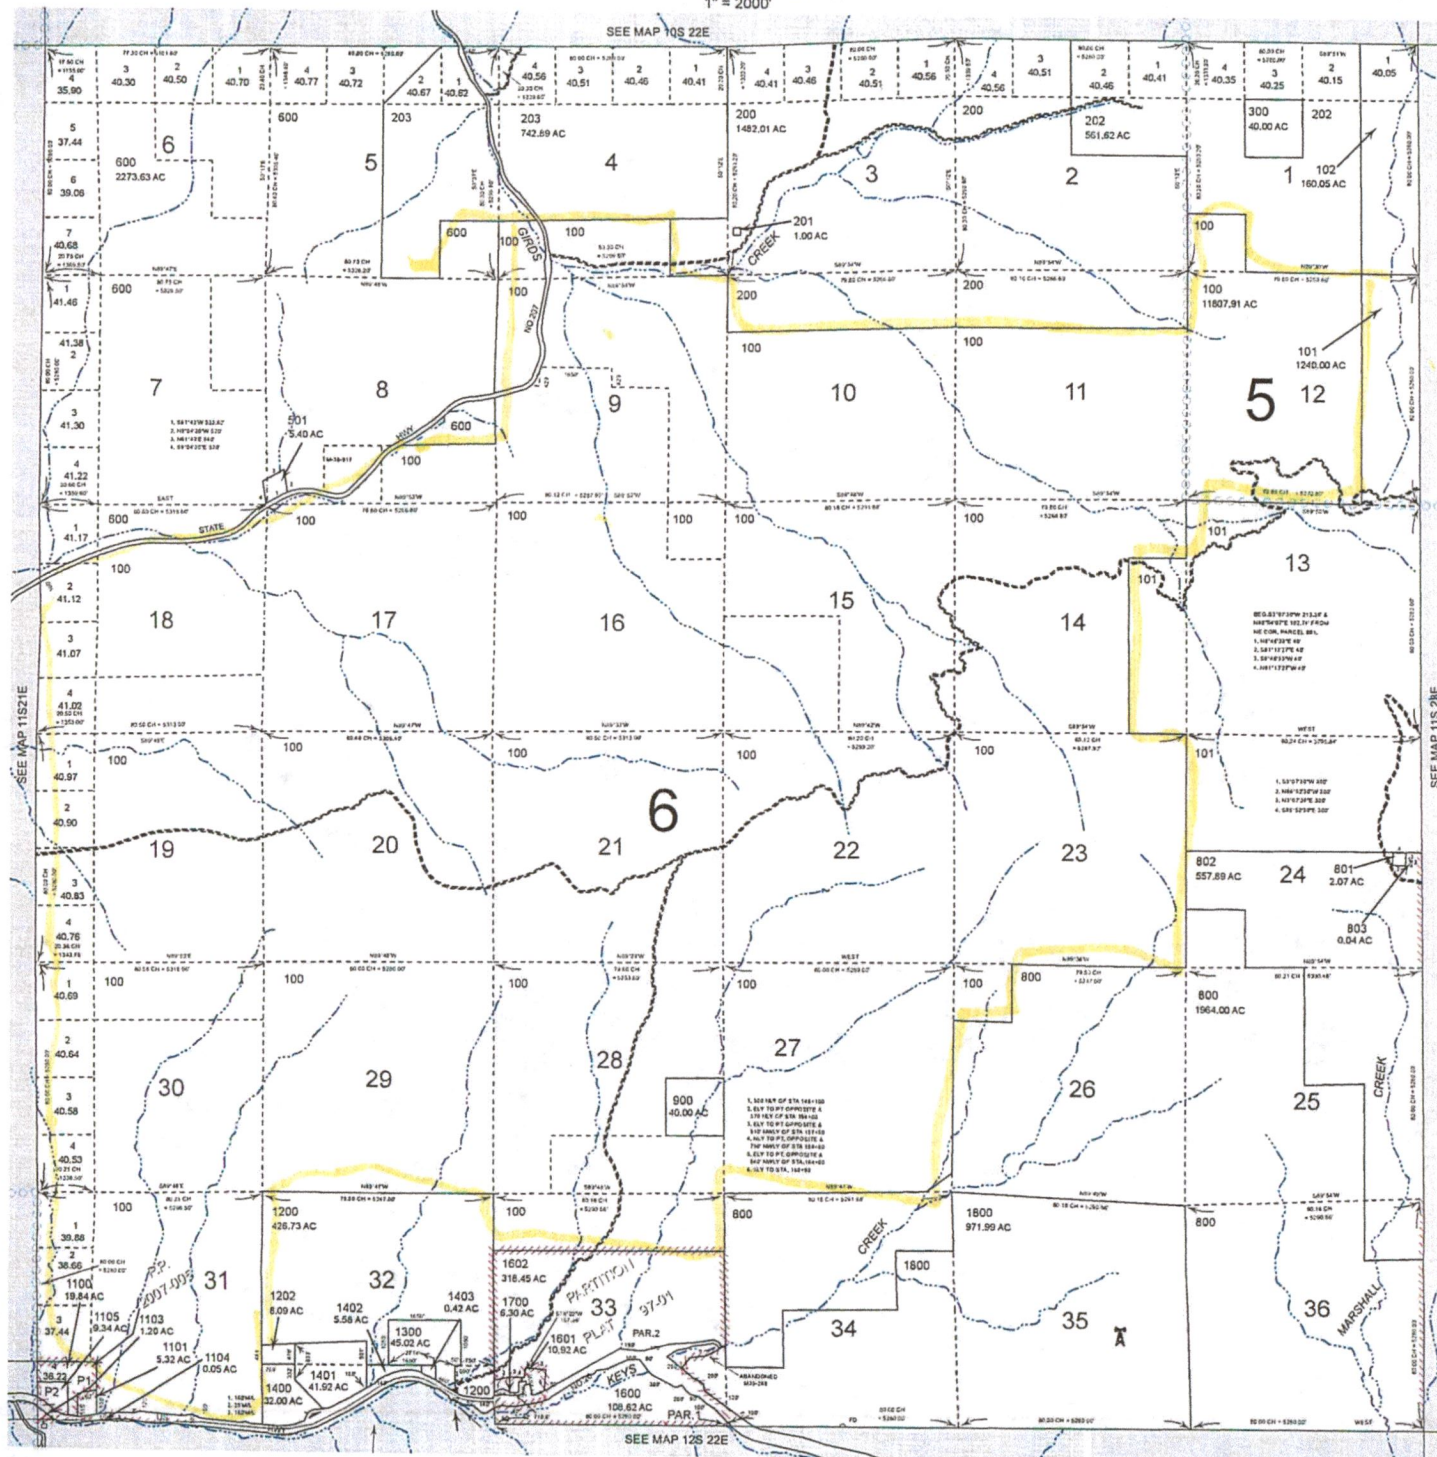

RECEIVED
FEB 04 2019
OWRD

11S22E

13118

Six Shooter Ranch

2011 Aerial Photo

Google Earth

Image © 2018 DigitalGlobe

RECEIVED

FEB 04 2019

OWRD



1000 ft

13118

Six Shooter Ranch

2013 Aerial Photo

RECEIVED
FEB 04 2018
OWRD

Google Earth

Image © 2018 DigitalGlobe



1000 ft

13118

Six Shooter Ranch

2014 Aerial Photo

RECEIVED
FEB 04 2019
OWRD

Google Earth

Image © 2018 DigitalGlobe



1000 ft

13118

Six Shooter Ranch

2017 Aerial Photo

RECEIVED

FEB 04 2019

OWRD



1000 ft

13118

Google Earth

Image © 2018 DigitalGlobe