COBU MAP # 1224 1/2 (A-5)

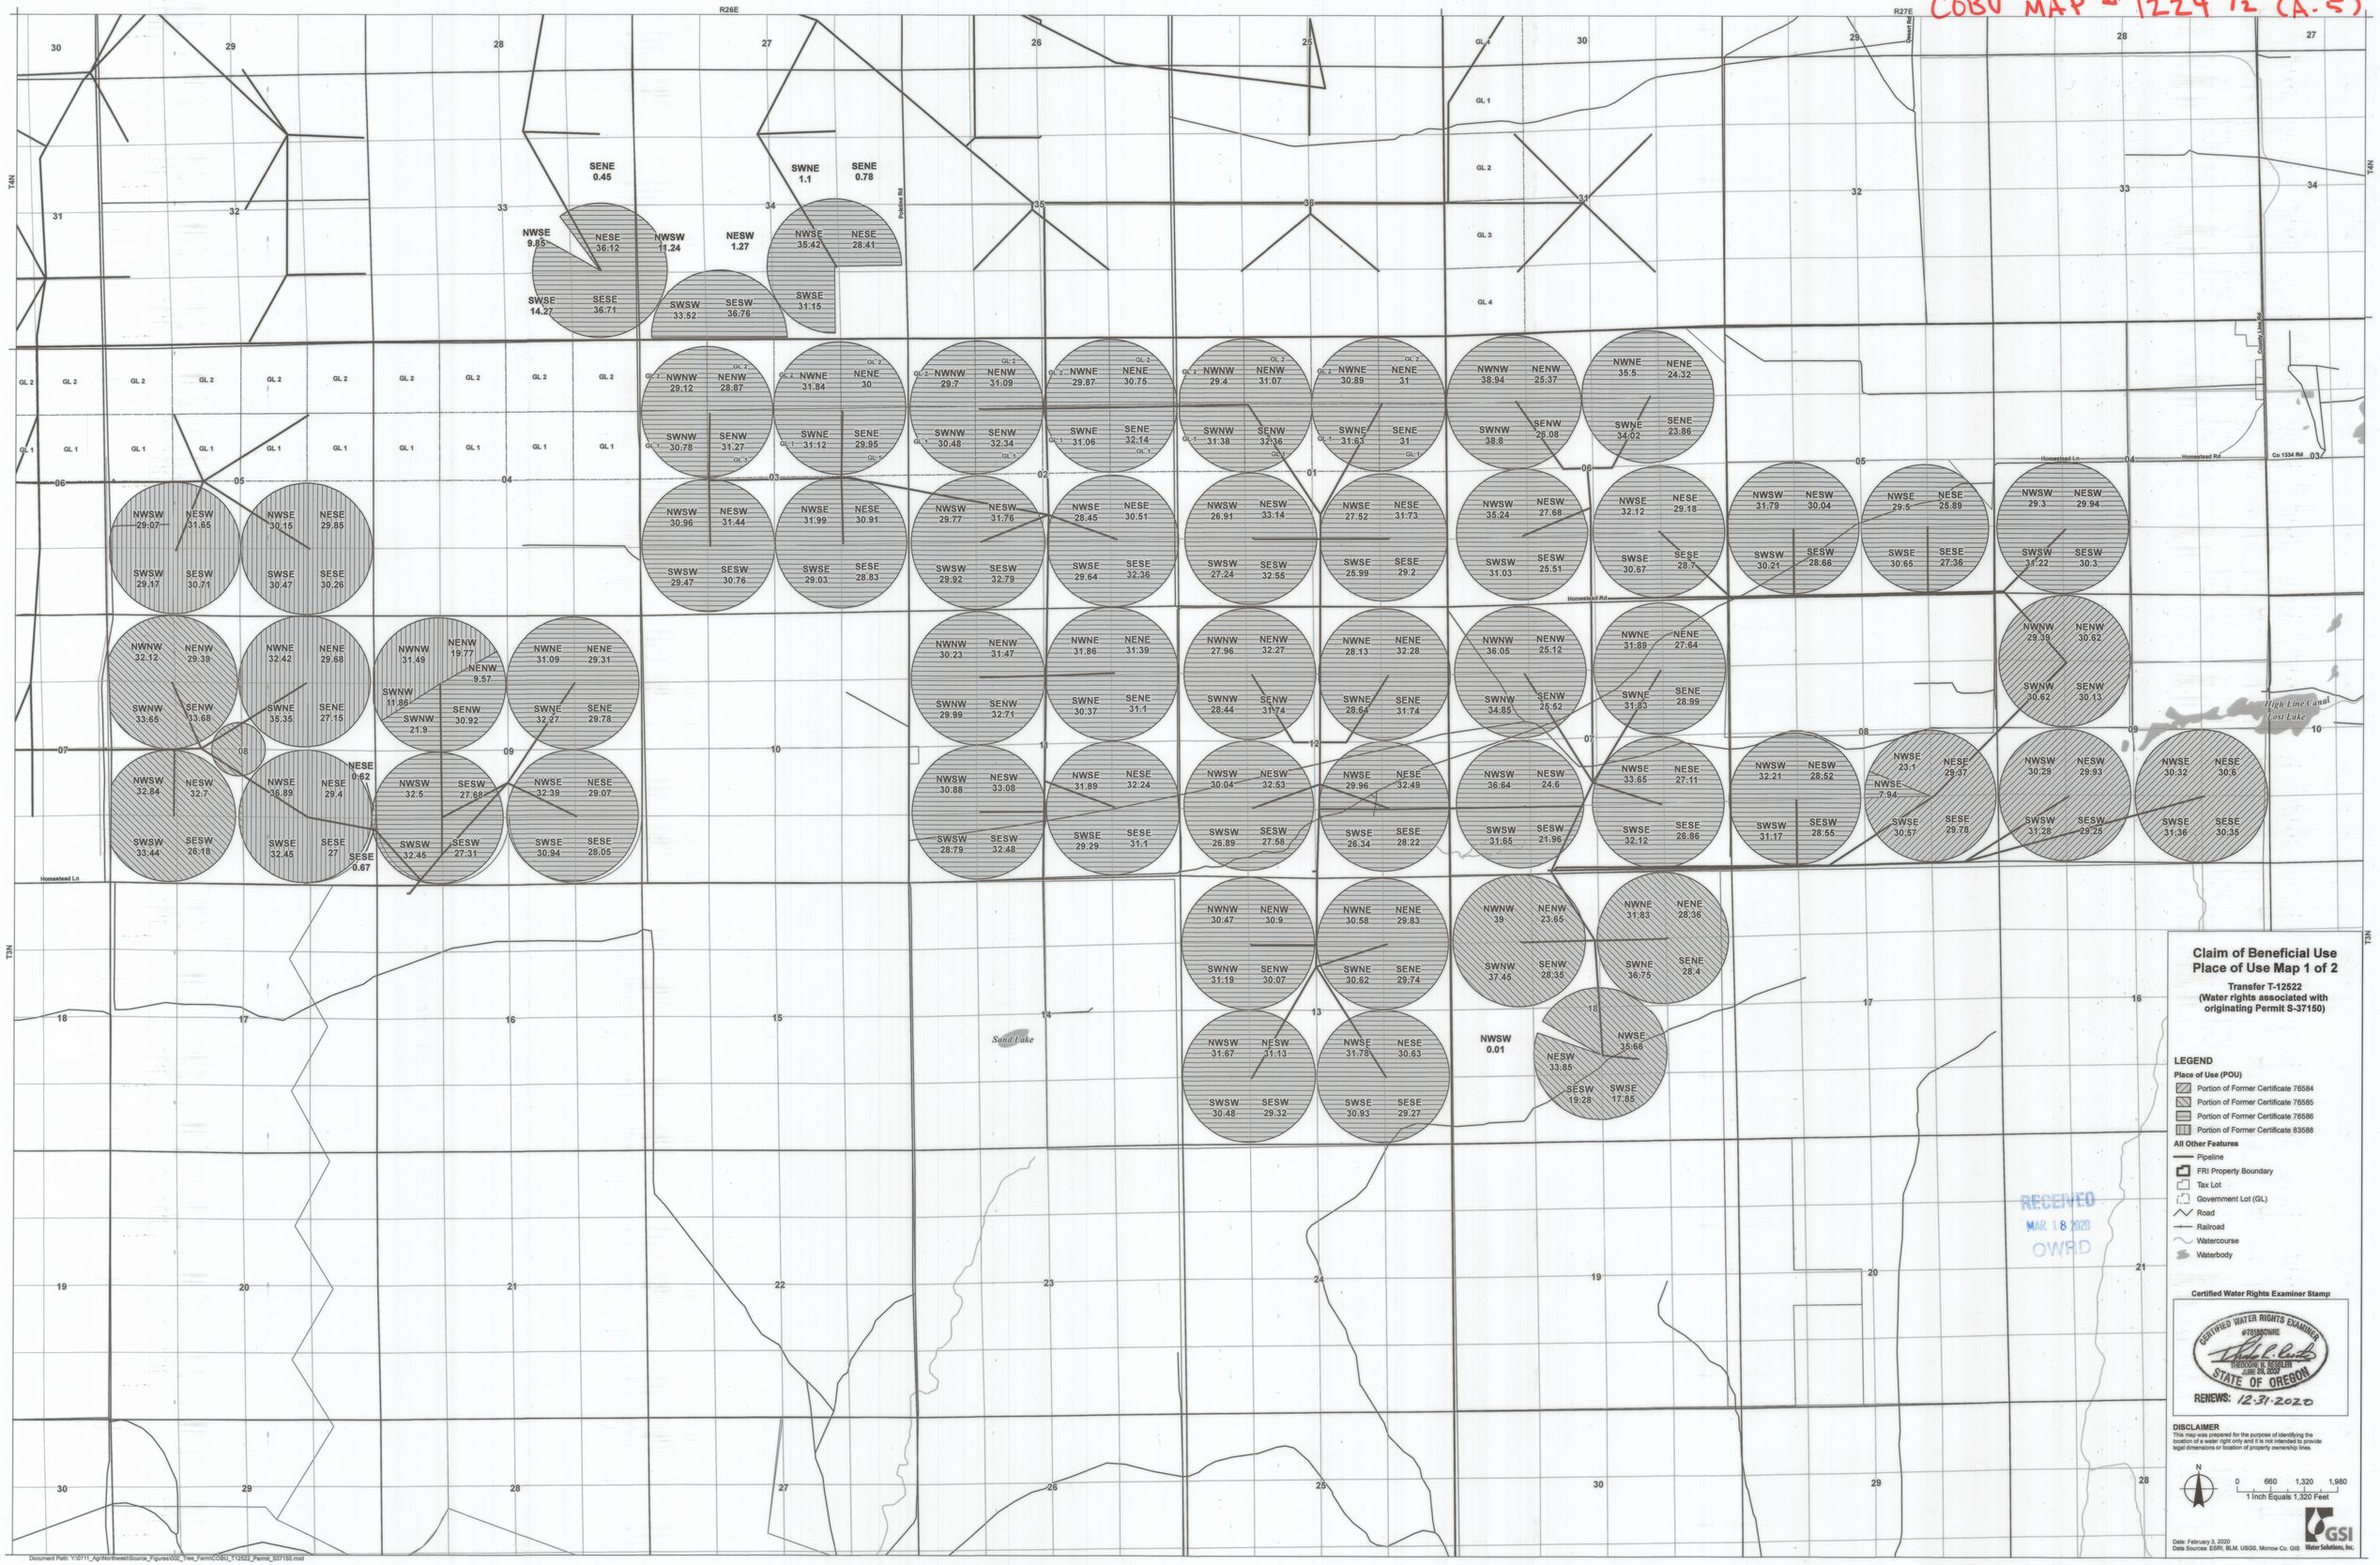

Claim of Beneficial Use
Place of Use Map 1 of 2

Transfer T-12522
(Water rights associated with originating Permit S-37150)

LEGEND

Place of Use (POU)

- Portion of Former Certificate 76584
- Portion of Former Certificate 76585
- Portion of Former Certificate 76586
- Portion of Former Certificate 83588

All Other Features

- Pipeline
- FRI Property Boundary
- Tax Lot
- Government Lot (GL)
- Road
- Railroad
- Watercourse
- Waterbody

Certified Water Rights Examiner Stamp

CERTIFIED WATER RIGHTS EXAMINER
#781800WRE
THEODORE R. RESSLER
JUNE 29, 2007
STATE OF OREGON
RENEWS: 12-31-2020

DISCLAIMER
This map was prepared for the purpose of identifying the location of a water right only and it is not intended to provide legal dimensions or location of property ownership lines.

N

0 660 1,320 1,980
1 Inch Equals 1,320 Feet

Date: February 3, 2020
Data Sources: ESRI, BLM, USGS, Morrow Co. GIS

GSI Water Solutions, Inc.

RECEIVED
MAR 18 2020
OWRD

Document Path: Y:\0711_Agri\Northwest\Source_Figures\002_Tree_Farm\COBU_T12522_Permit_S37150.mxd