
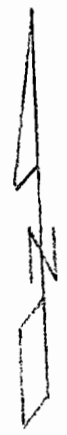
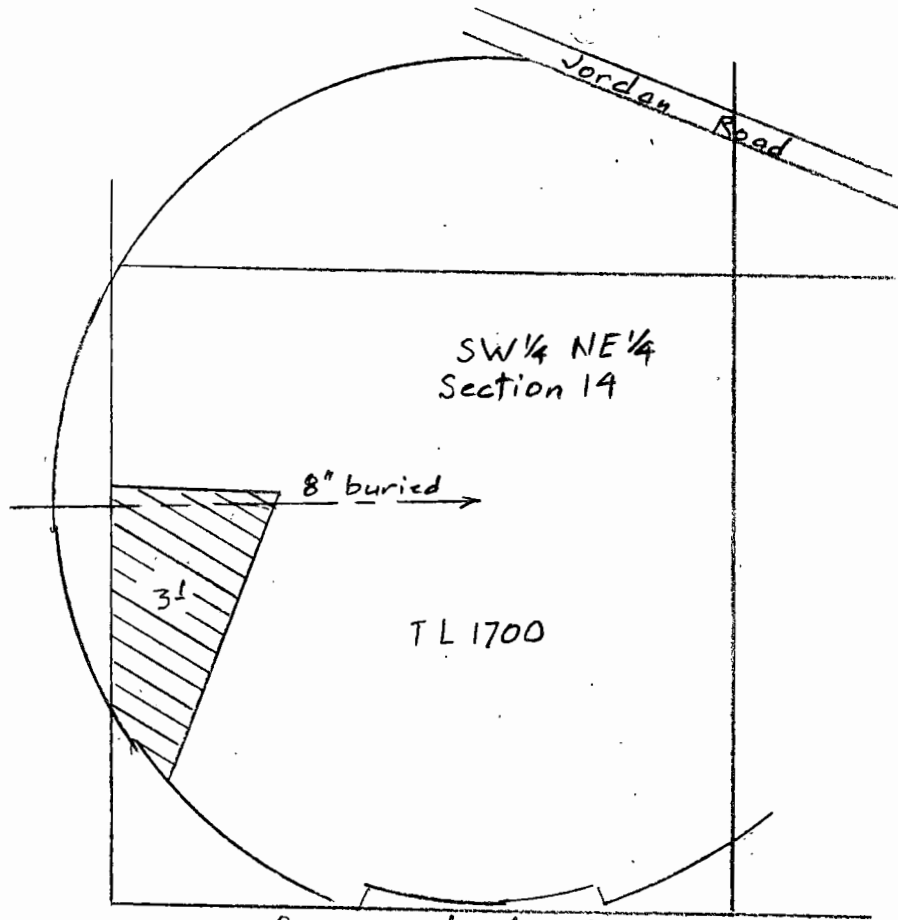


10 | 11
15 | 14

T. 15 S., R. 10 E., W. M.

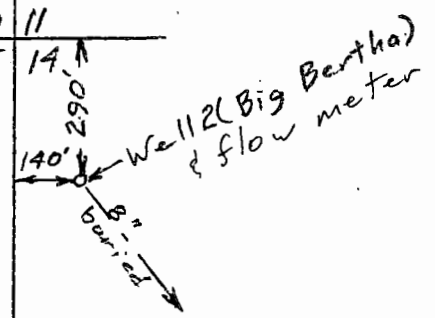

Scale 1" = 400'

RECEIVED BY OWNER

JAN 27 2017

SALEM, OR

T-12188

Claim of Beneficial Use Map
for
Ski Pond Ranch, LLC

This map is for the purpose of locating a water right only and has no intent to provide legal dimensions or the location of property lines.



ESTES SURVEYS, LLC
 PO Box 47519 60382 Arnold Rd
 Salem, OR 97305-7519 Bend, OR 97702
 (503) 585-7599 (541) 382-7391