


COBU MAP 1067

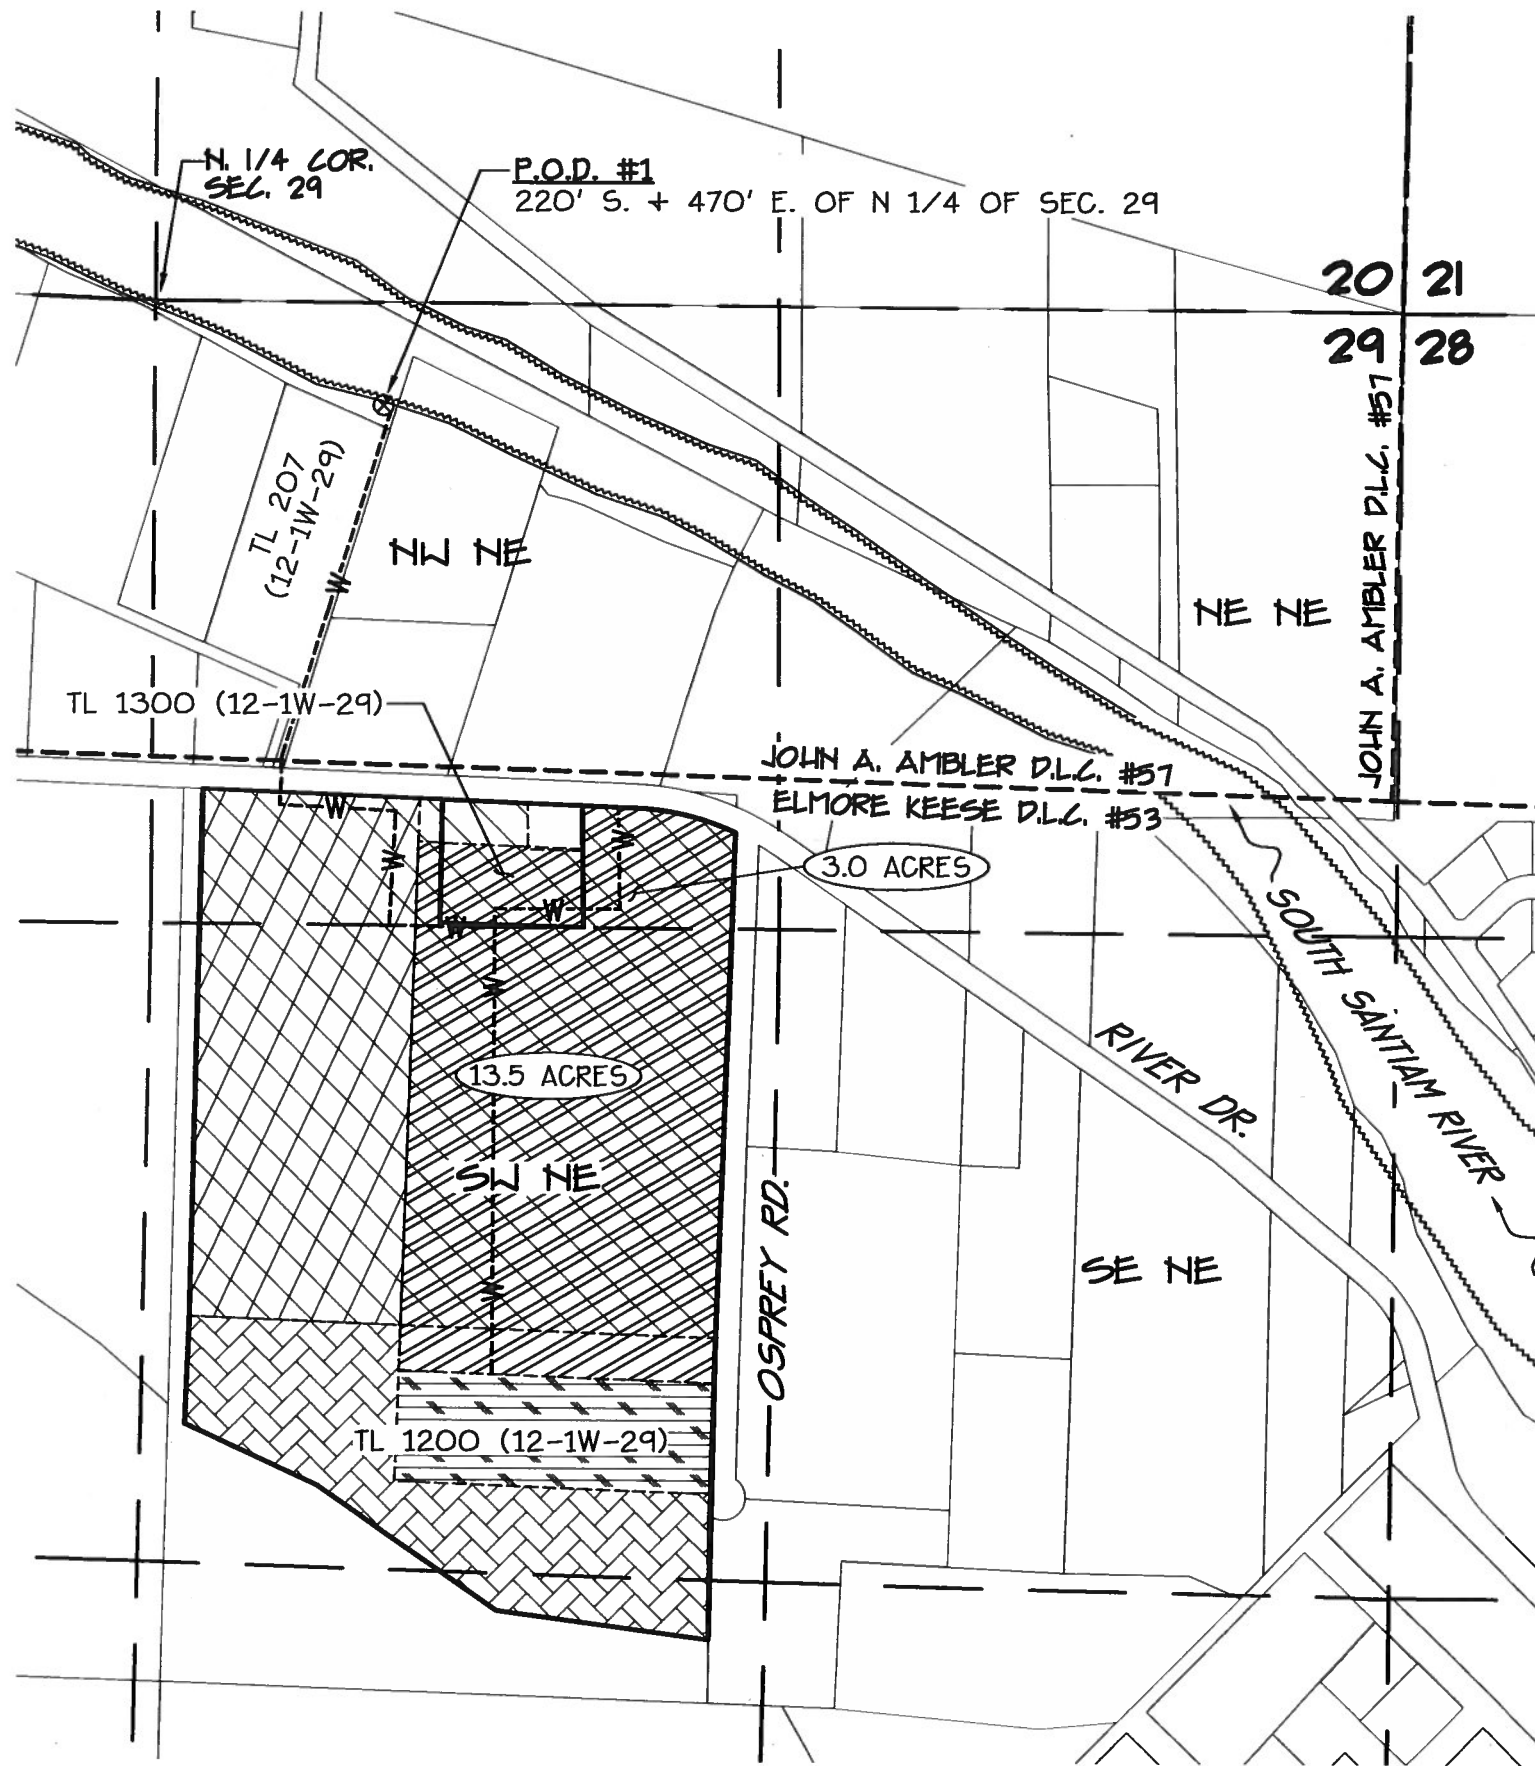


CLAIM OF BENEFICIAL USE MAP FOR VAN ESSEN NURSERY

LOCATED IN

THE ELMORE KEESE D.L.C. No. 53
AND THE JOHN A. AMBLER D.L.C. #57
NE 1/4 SEC. 29, T. 12 S., R. 1 W., W.M.
LINN COUNTY, OREGON

JANUARY 24, 2017

TRANSFER T-12007

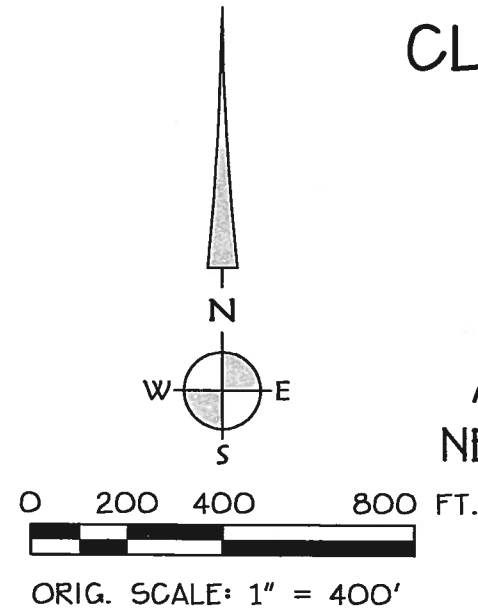

LEGEND:

- TRANSFER T-12007
(TO BE PERFECTED BY THIS CLAIM)
IRRIGATION OF 16.5 ACRES
- NURSEY USE PORTION OF TRANSFER T-12371
(ORIGINALLY PERMIT 5-53870)
27.5 ACRES
- IRRIGATION PORTION OF TRANSFER T-12371
(ORIGINALLY PERMIT 5-53870)
11.0 ACRES
- CERTIFICATE 91213
IRRIGATION OF 8.4 ACRES
- CERTIFICATE 62740
IRRIGATION OF 3.5 ACRES
- 13.5 ACRES
ACERAGE FOR IRRIGATION USE PER 1/4 1/4 SECTION PER T-12007
- POINT OF DIVERSION W/ APPROVED FISH SCREEN
PUMP AND ATTACHED METER IS APPROX. 20' SOUTH OF P.O.D.
- IRRIGATION MAINLINE (MAINLINE ALSO SERVICES ADJACENT
WATER RIGHTS)



RECEIVED

FEB 03 2017

OWRD

IRRIGATION NOTE:

MAILINE SHOWN IS BURIED 4" LINE, LATERAL LINES ARE NOT SHOWN ON THIS MAP.
LOCATION OF MAINLINE IS BASED ON SCHEMATICS OF THE SYSTEM.

NOTE:

THIS MAP IS NOT INTENDED TO PROVIDE LEGAL DIMENSIONS OR LOCATION OF PROPERTY OWNERSHIP. INFORMATION ON THIS MAP IS COMPILED FROM 2016 LINN COUNTY GIS DATA.

