

MAP FOR


# Claim of Beneficial Use

S19, T16S, R3W, LANE COUNTY

Appl G-15693, Permit G-15619



1 IN = 1320 FT  
0 660 1320

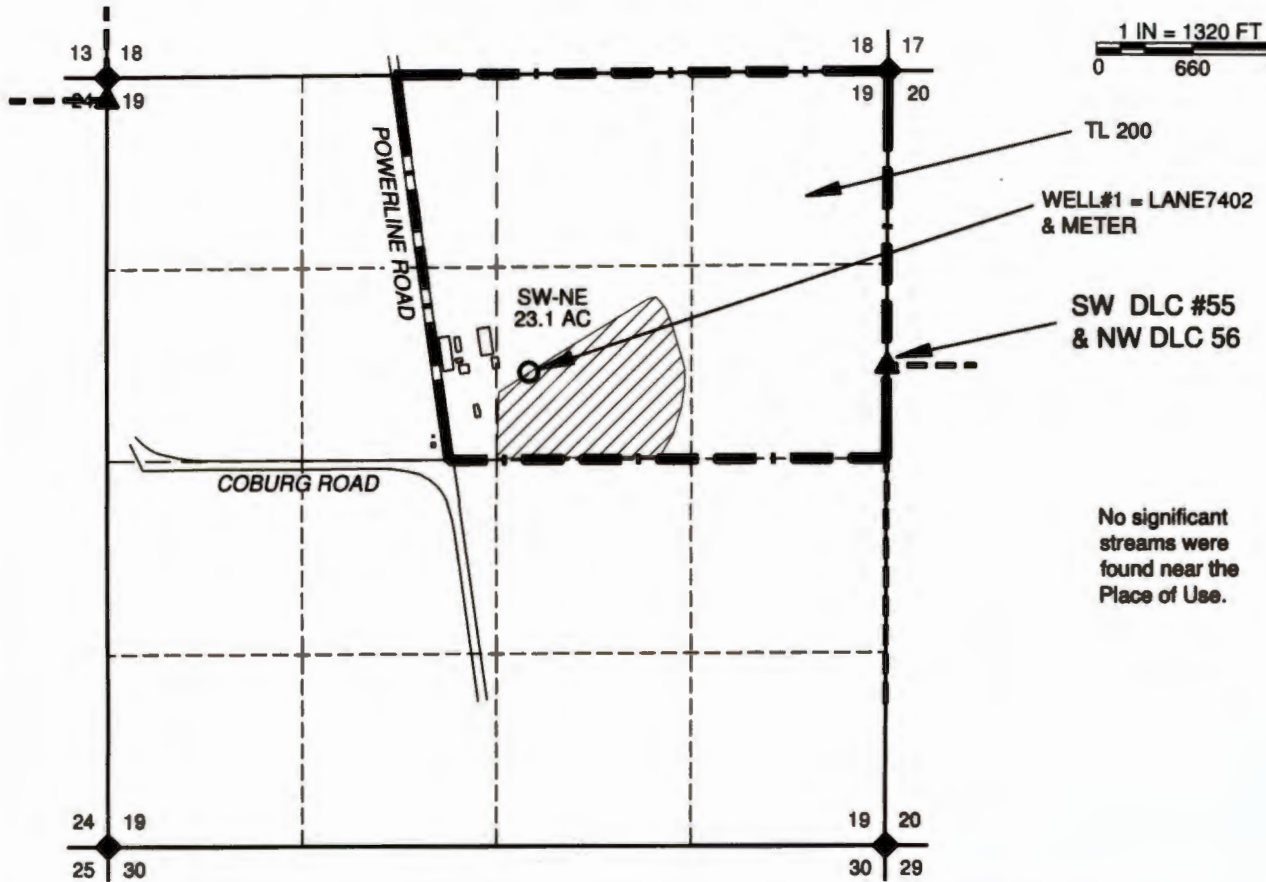

POD1 IS 45' SOUTH AND 2450' WEST FROM THE SW CORNER DLC#55.

## LEGEND

- ▲ DONATION LAND CLAIM (DLC) CORNER
- STREAM OR SURFACE DRAINAGE (NONE NEAR SITE)
- ◆ SECTION OR QUARTER CORNER
- POINT OF DIVERSION
- - - TAX LOT LINE
- SECTION LINE
- - - QUARTER-QUARTER LINE
- - - DLC LINES
- ▨ IRRIGATED AREA

## NOTES:

THIS MAP IS NOT INTENDED TO PROVIDE LEGAL DIMENSIONS OR LOCATIONS OF PROPERTY OWNERSHIP LINES.  
-PROPERTY LINES AND QUARTER-QUARTER LINES ARE BASED ON THE TAX ASSESSOR MAP FOR SECTION 19, T6S, R3W. IRRIGATION AND WELL LOCATION IS BASED ON AERIAL PHOTOGRAPHY FROM GOOGLE MAPS.  
-THE WELL COORDINATES VARY FROM THE PERMIT COORDINATES AND THE REFERENCE CORNER ON THE PERMIT IS DIFFICULT TO FIND SO THIS MAPS SHOWS CORRECT COORDINATES FROM A DLC CORNER.  
-THERE ARE NO DLC LINES OR GOVERNMENT LOTS WITHIN THE PLACE OF USE.  
-WATER CONVEYANCE LINES ARE WITHIN THE PROPERTY AND THEREFORE ARE NOT SHOWN.



MAP BY:  
**ASPEN RURAL LAND  
CONSULTING**

ERIC URSTADT, PE, PLS  
971-250-1520  
Jan 2017  
Hayworth1D