

COBU MAP # 1097

CLAIM OF BENEFICIAL USE WATER RIGHTS MAP

MID COAST BASIN
UNDER PERMIT S-54032
FILE # S-85675

19-12-27-1-4, TL 3300 & 3400
SE 1/4 NE 1/4, SEC. 27, T19S, R12W, W.M.
LANE COUNTY, OREGON


FOR: LOREN POST MARITAL TRUST
2364 GREINER ST
EUGENE, OREGON 97405

PREPARED BY: WOBBE & ASSOCIATES, INC.
510 KINGWOOD ST. / P.O. BOX 3093
FLORENCE, OR 97439
DATE: SEPTEMBER 26, 2017

RECEIVED BY OWRD

SEP 28 2017

SALEM, OR

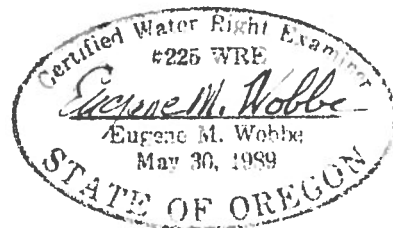

exp 6-30-2018

GRID NORTH
OREGON SOUTH ZONE

