

Claim of Beneficial Use
Application G-16527 Permit G-16220
In the name of Antonia Oliver
Revised 8/6/2020

RECEIVED

AUG 12 2020

OWRD

Revised 8/6/2020




Renewal date: 6/30/2022




Well Location

1140' South and 1160' East from Center Quarter
Corner of Section 11

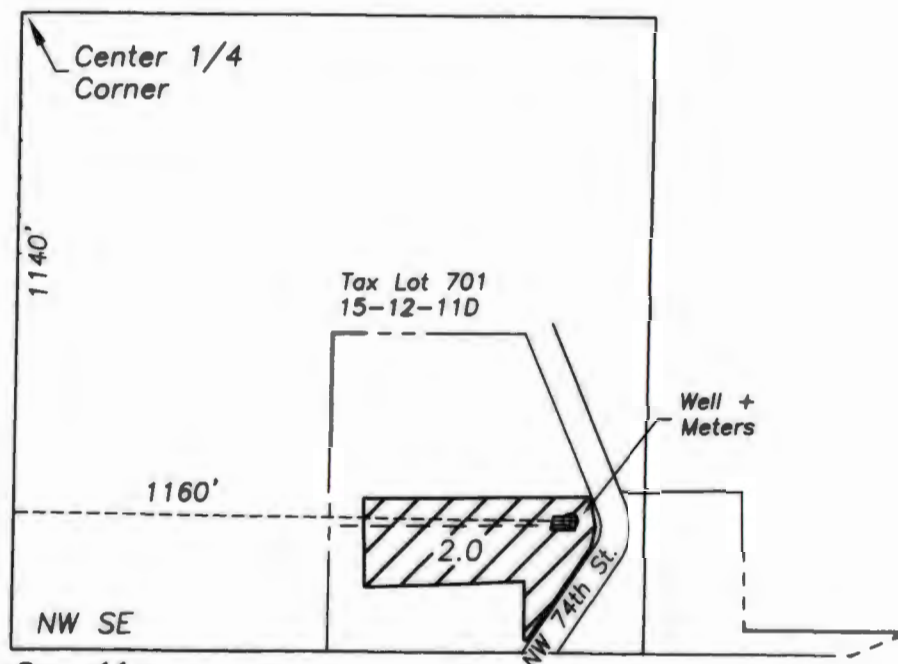

Sec. 11
T15S, R12E, WM
Deschutes Co. OR

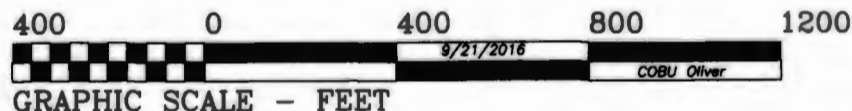

This map is for the purpose of identifying the location of the water right. It is not intended to provide legal dimensions or locations of property ownership lines.

Legend



Water beneficially applied under Permit
G-16220, priority date 9/7/2005

----- Property line

----- Mainline