

RECEIVED


JUN 21 2021

OWRO

T. 23S., R12W., W.M.

NW 1/4 SW 1/4 OF SECTION 9
COOS COUNTY

Christopher Foster Clark
1850 E. BIRCH AVENUE, APT. #113
FRESNO, CA. 93720-3846

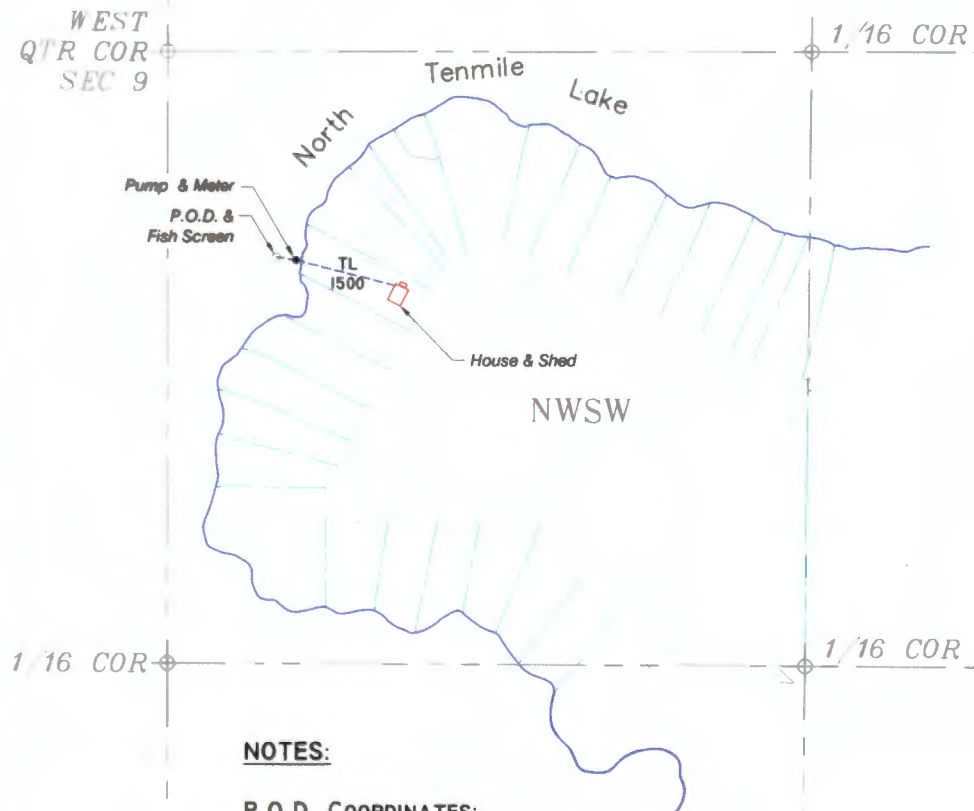

PREPARATION OF THIS MAP
IS FOR THE PURPOSE OF
IDENTIFYING THE LOCATION
OF THE WATER RIGHT ONLY.
THERE IS NO INTENT TO
PROVIDE DIMENSIONS OR
LOCATION OF PROPERTY
OWNERSHIP LINES.



SCALE: 1"=400'

NOTES:

P.O.D. COORDINATES:

NW 1/4 SW 1/4 of Section 9, T. 23 S, R. 12 W., W.M.
430 feet South and 1120 Feet West from the
C-W 1/16 Corner, Section 9.

LEGEND

- PROPERTY LINE
- - - USGS GRID
- ROADWAY
- STRUCTURE
- WATER
- - - 1" PVC PIPING
- ⊕ 1/4 OR 1/16 CORNER
- DIVERSION POINT (P.O.D.)
- PUMP

Survey

AND CLAIM OF BENEFICIAL USE UNDER
APPLICATION No. S-87629
PERMIT No. S-54747

FILE PATH & NAME: C:\BK\CLARK_GEORGE\R2\CLARK 030517.dwg

BK WATER RIGHT CONSULTING
PO Box 13434 Salem, Oregon 97309

Clark COBU

APPLICATION#: S-87629 PERMIT#: S-54747 AMENDMENT#: x-xxxxx SHEET 1 OF 1