


Claim of Beneficial Use

APPLICATION S-88183

PERMIT S-55048

TOWNSHIP 26 S., RANGE 6 W., W.M. - SECTION 27

DOUGLAS COUNTY, OREGON

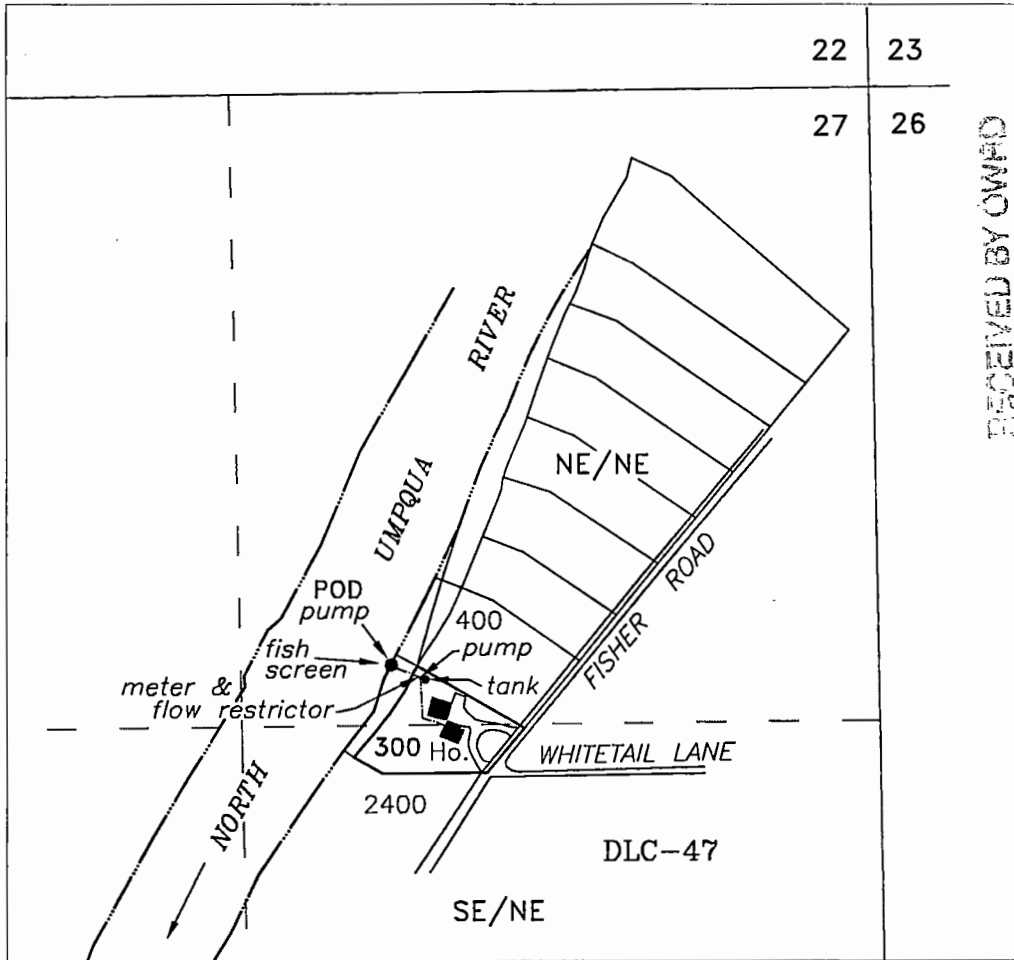

RECEIVED BY OWAD

DEC 01 2017

GALINA OPI

LEGEND


POD - NE/NE, section 27, DLC-47, 1205 feet South & 990 feet West from the NE Corner of section 27

Prepared For:

Durel B. Shrum Jr.
1890 Fisher Road
Roseburg, OR 97471

Domestic Use Expanded
Tax Lot 300

Base map - Douglas County GIS Tax Lots over 11/1/17 Oregon Map & 7/15/2015 Google aerial photos for assumed best fit. Survey maps CS 51/219-2 & 3 and BLM corners map used for orientation and control

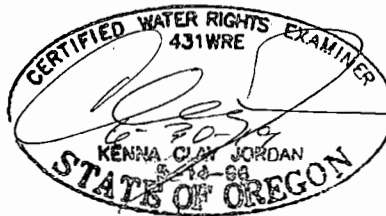

This map is not intended to provide legal dimensions or locations of property ownership lines

Assessor Map #
T-26S, R6W-27A



1" = 400'

JORDAN ENGINEERING

460 JORDAN LANE
ROSEBURG, OREGON 97471
(541) 673-1931

11/12/2017 n.e.d.